



City of Chicago



Or2017-129

Office of the City Clerk

Document Tracking Sheet

Meeting Date:	3/29/2017
Sponsor(s):	Napolitano (41)
Type:	Order
Title:	Issuance of permits for sign(s)/signboard(s) at 11601 W Touhy Ave - Sign 2
Committee(s) Assignment:	Committee on Zoning, Landmarks and Building Standards

Committee on Zoning, Landmarks and Building Standards

(signs)

ORDERED, That the Commissioner of Buildings is hereby directed to issue 1 sign permit to:


Grate Signs
4044 W McDonough
Joliet, IL 60431


For the erection of one (1) awning sign over 24 feet in height and/or over 100 square feet (in area of one face) at:

11601 W Touhy
Chicago, IL 60666

#1	Dimensions: length <u>26 feet</u>	height <u>17 feet 8 inches</u>
	Height above grade/roof to top of sign	<u>38 feet</u>
	Total Square Foot Area	<u>459 square feet</u>
	Elevation	<u>East</u>

Such sign shall comply with all applicable provisions of TITLE 17 of the Chicago Zoning Ordinance and all other applicable provisions of the Municipal Code of the City of Chicago governing the construction and maintenance of outdoor signs, signboards and structures.


Anthony V Napolitano
Alderman, 41st Ward

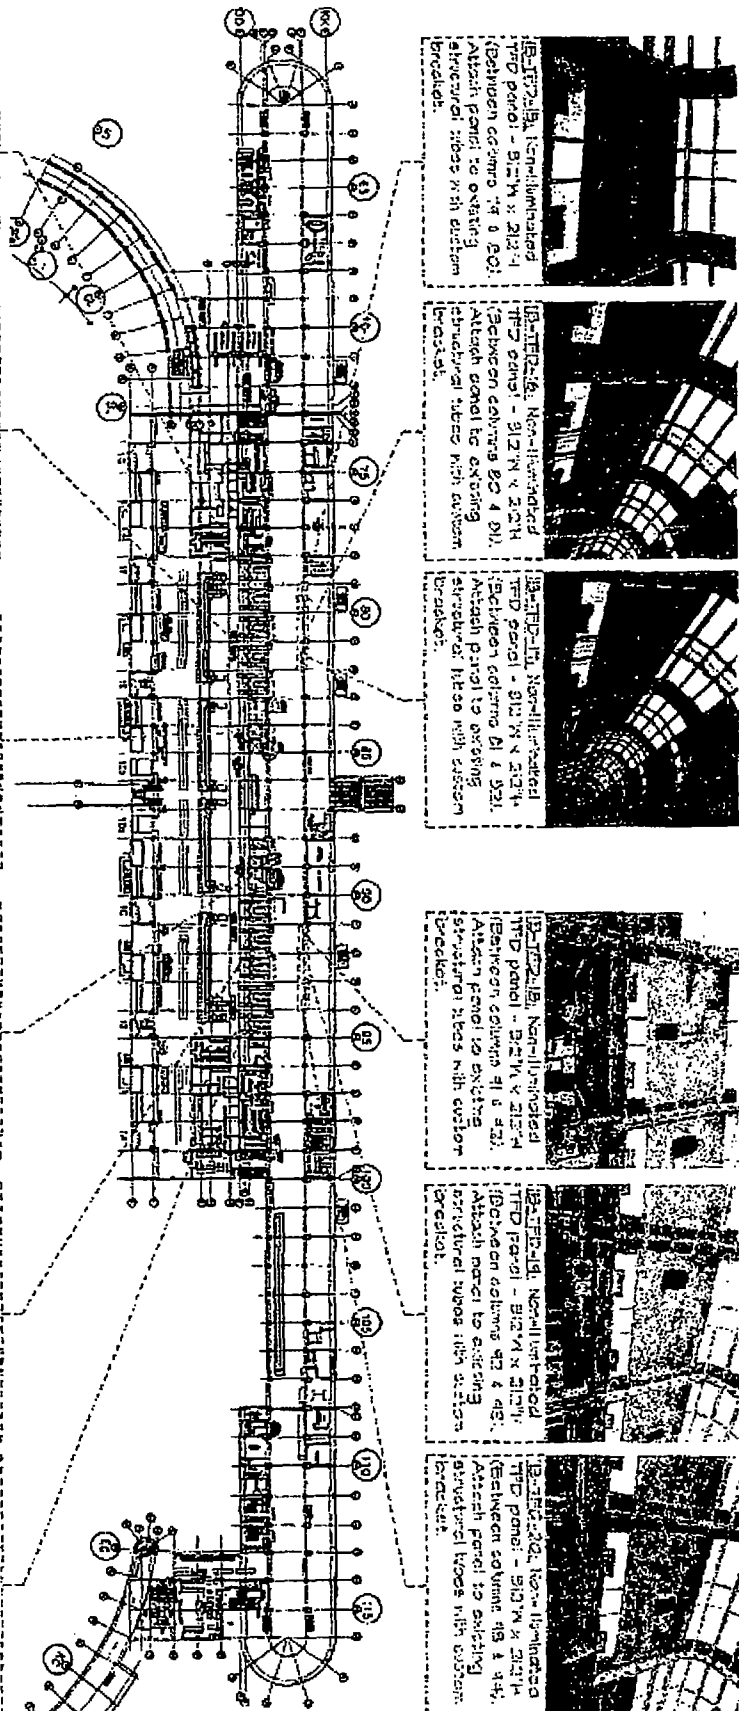

1B-1F2-1a: Non-illuminated TFD panel - 81.2'W x 212.4' (Between columns 81 & 82). Attach panel to existing structural steel with custom bracket.

1B-1F2-1a: Non-illuminated TFD panel - 81.2'W x 212.4' (Between columns 82 & 83). Attach panel to existing structural steel with custom bracket.

1B-1F2-1a: Non-illuminated TFD panel - 81.2'W x 212.4' (Between columns 81 & 82). Attach panel to existing structural steel with custom bracket.

1B-1F2-1b: Non-illuminated TFD panel - 81.2'W x 212.4' (Between columns 81 & 82). Attach panel to existing structural steel with custom bracket.

1B-1F2-1d: Non-illuminated TFD panel - 81.2'W x 212.4' (Between columns 82 & 83). Attach panel to existing structural steel with custom bracket.

1B-1F2-2a: Non-illuminated TFD panel - 81.2'W x 212.4' (Between columns 83 & 84). Attach panel to existing structural steel with custom bracket.

1B-1F2-1a: Non-illuminated TFD - 81.2'W x 212.4' (Between columns 81 & 82). Attach panel to existing building columns with high strength cables.

1B-1F2-1a: Non-illuminated TFD - 81.2'W x 212.4' (Between columns 82 & 83). Attach panel to existing building columns with high strength cables.

1B-1F2-1a: Non-illuminated TFD - 81.2'W x 212.4' (Between columns 81 & 82). Attach panel to existing building columns with high strength cables.

1B-1F2-1b: Non-illuminated TFD - 81.2'W x 212.4' (Between columns 81 & 82). Attach panel to existing building columns with high strength cables.

1B-1F2-1d: Non-illuminated TFD - 81.2'W x 212.4' (Between columns 82 & 83). Attach panel to existing building columns with high strength cables.

1B-1F2-2a: Non-illuminated TFD - 81.2'W x 212.4' (Between columns 83 & 84). Attach panel to existing building columns with high strength cables.

LOCATION PLAN - TERMINAL 1 CONCOURSE B - Upper Level



TFD

<p>PROJECT</p> <p>CCA - TFD, PHASE I</p> <p>OWARE INTERNATIONAL AIRPORT</p> <p>11601 WEST TOLUAY AVE</p> <p>CHICAGO, IL 60666</p>	<p>CCA Project No:</p> <p>TM1311113-00</p>	<p>PARACHIN design studios, Inc.</p> <p>140 west Adams Street, Suite 401</p> <p>Chicago, Illinois 60605</p> <p>ph 312-424-2260 fax 312-679-3265</p>	<p>314.541.5635</p> <p>TomLee@TLCLLC.com tomlee.com</p>
<p>CD A 1008 9/7/14</p> <p>REVISION 11/20/15</p> <p>CD A 608 7/30/15</p> <p>AS-BUILT 01/04/16</p> <p>Date:</p>	<p>Sheet No:</p> <p>C-3</p>	<p>Scale:</p> <p>1/4" = 1'-0"</p>	<p>DATE</p> <p>11/20/15</p>