



City of Chicago



Or2017-138

Office of the City Clerk

Document Tracking Sheet

Meeting Date:	3/29/2017
Sponsor(s):	Napolitano (41)
Type:	Order
Title:	Issuance of permits for sign(s)/signboard(s) at 11601 W Touhy Ave - Sign 11
Committee(s) Assignment:	Committee on Zoning, Landmarks and Building Standards

Committee on Zoning, Landmarks and Building Standards

(signs)

ORDERED, That the Commissioner of Buildings is hereby directed to issue 1 sign permit to:


Grate Signs
4044 W McDonough
Joliet, IL 60431

For the erection of one (1) awning sign over 24 feet in height and/or over 100 square feet (in area of one face) at:

11601 W Touhy
Chicago, IL 60666

#1	Dimensions: length <u>25 feet</u>	height <u>12 feet</u>
	Height above grade/roof to top of sign	<u>32 feet</u>
	Total Square Foot Area	<u>300 square feet</u>
	Elevation	<u>West</u>


Such sign shall comply with all applicable provisions of TITLE 17 of the Chicago Zoning Ordinance and all other applicable provisions of the Municipal Code of the City of Chicago governing the construction and maintenance of outdoor signs, signboards and structures.


Anthony V Napolitano
Alderman, 41st Ward

LOCATION PLAN - TERMINAL | CONCOURSE B - Upper Level



TFD

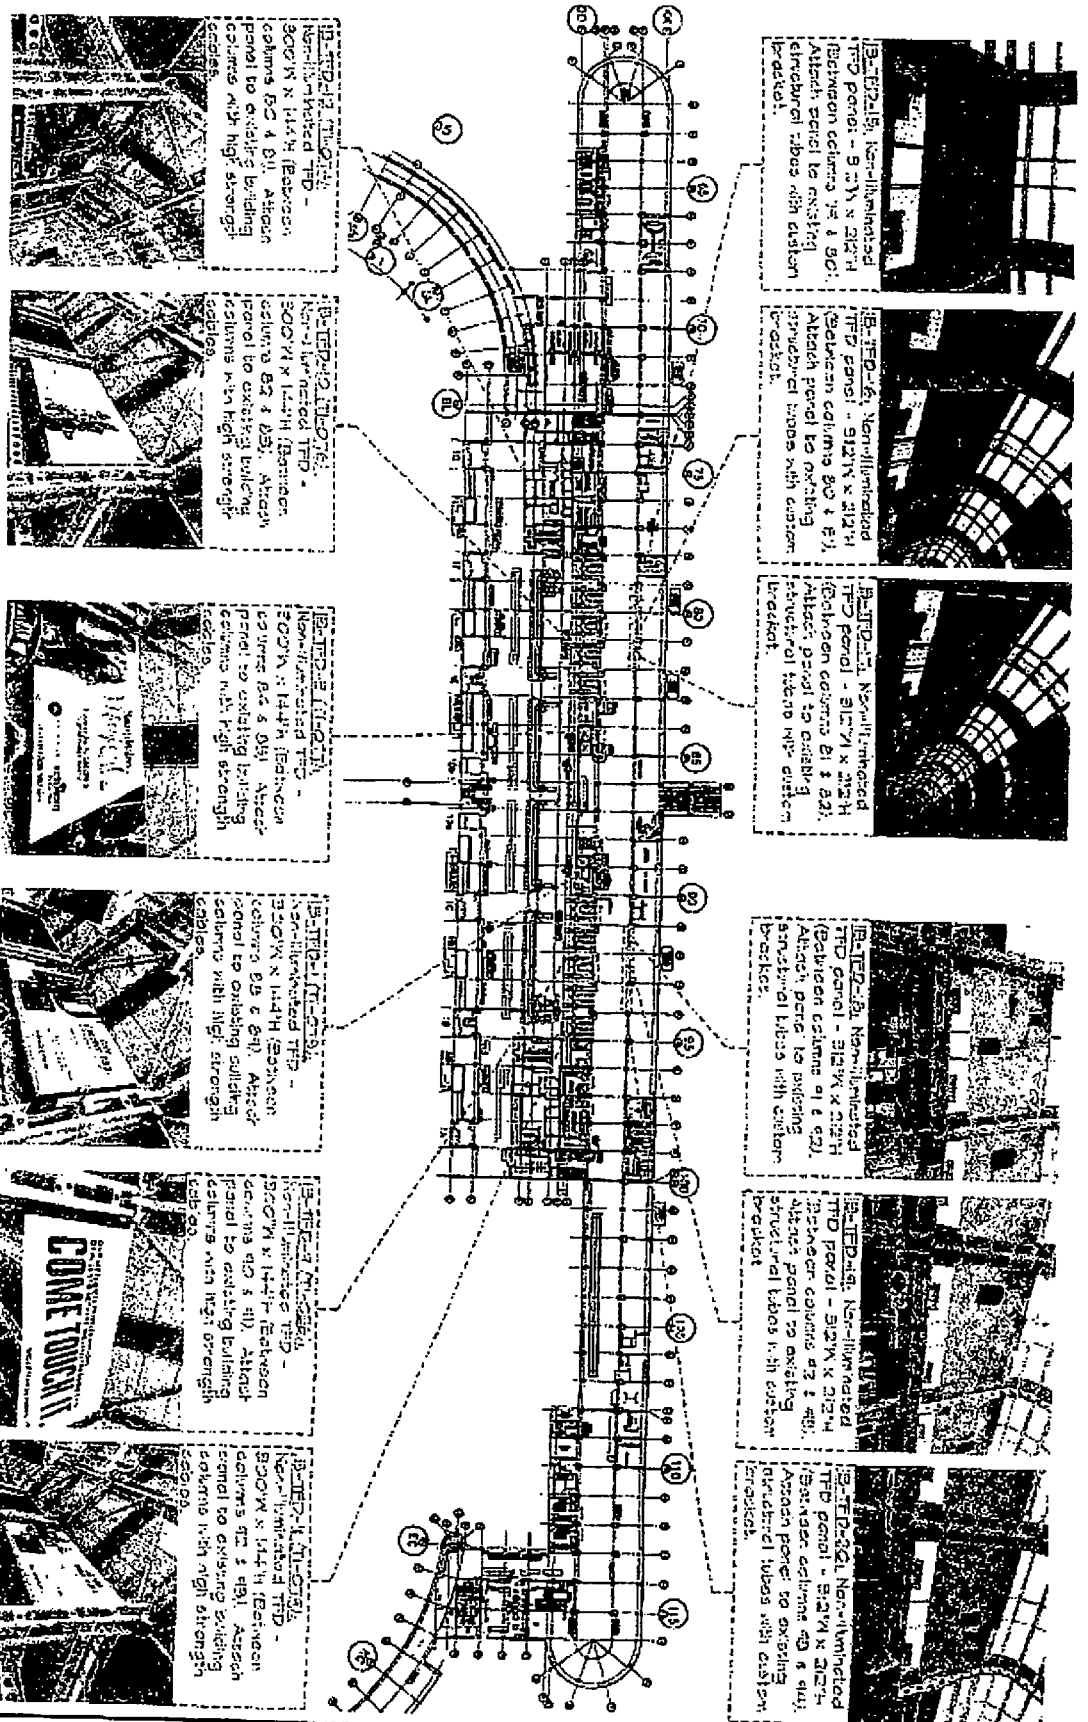

PROJECT CGA - TFD, PHASE I O'HARE INTERNATIONAL AIRPORT 11601 WEST TOWHY AVE. CHICAGO, IL 60666	CGA Project No: TH1311.13-00	PARACHIN design studios, Ltd. 900 West Adams Street, Suite 417 Chicago, Illinois 60607 ph. 312-829-2260 fax 312-879-2265	
		314.541.5635 Tom.Lee@TLELLC.onmicrosoft.com	
Clear Channel Airports		TLELLC CONSULTING	
CDIA LOG#: 5/7/14 REVISION: 1/20/13 CDA 603 - 7/30/13 AS-BUILT - 01/04/16 Description: Date:	Sheet No: C-3	TLU-TFD	