



City of Chicago



Or2017-130

Office of the City Clerk

Document Tracking Sheet

Meeting Date:	3/29/2017
Sponsor(s):	Napolitano (41)
Type:	Order
Title:	Issuance of permits for sign(s)/signboard(s) at 11601 W Touhy Ave - Sign 3
Committee(s) Assignment:	Committee on Zoning, Landmarks and Building Standards

Committee on Zoning, Landmarks and Building Standards

(signs)

ORDERED, That the Commissioner of Buildings is hereby directed to issue 1 sign permit to:


Grate Signs
4044 W McDonough
Joliet, IL 60431

For the erection of one (1) awning sign over 24 feet in height and/or over 100 square feet (in area of one face) at:


11601 W Touhy
Chicago, IL 60666

#1	Dimensions: length <u>25 feet</u>	height <u>12 feet</u>
	Height above grade/roof to top of sign	<u>32 feet</u>
	Total Square Foot Area	<u>300 square feet</u>
	Elevation	<u>West</u>

Such sign shall comply with all applicable provisions of TITLE 17 of the Chicago Zoning Ordinance and all other applicable provisions of the Municipal Code of the City of Chicago governing the construction and maintenance of outdoor signs, signboards and structures.


Anthony V Napolitano
Alderman, 41st Ward



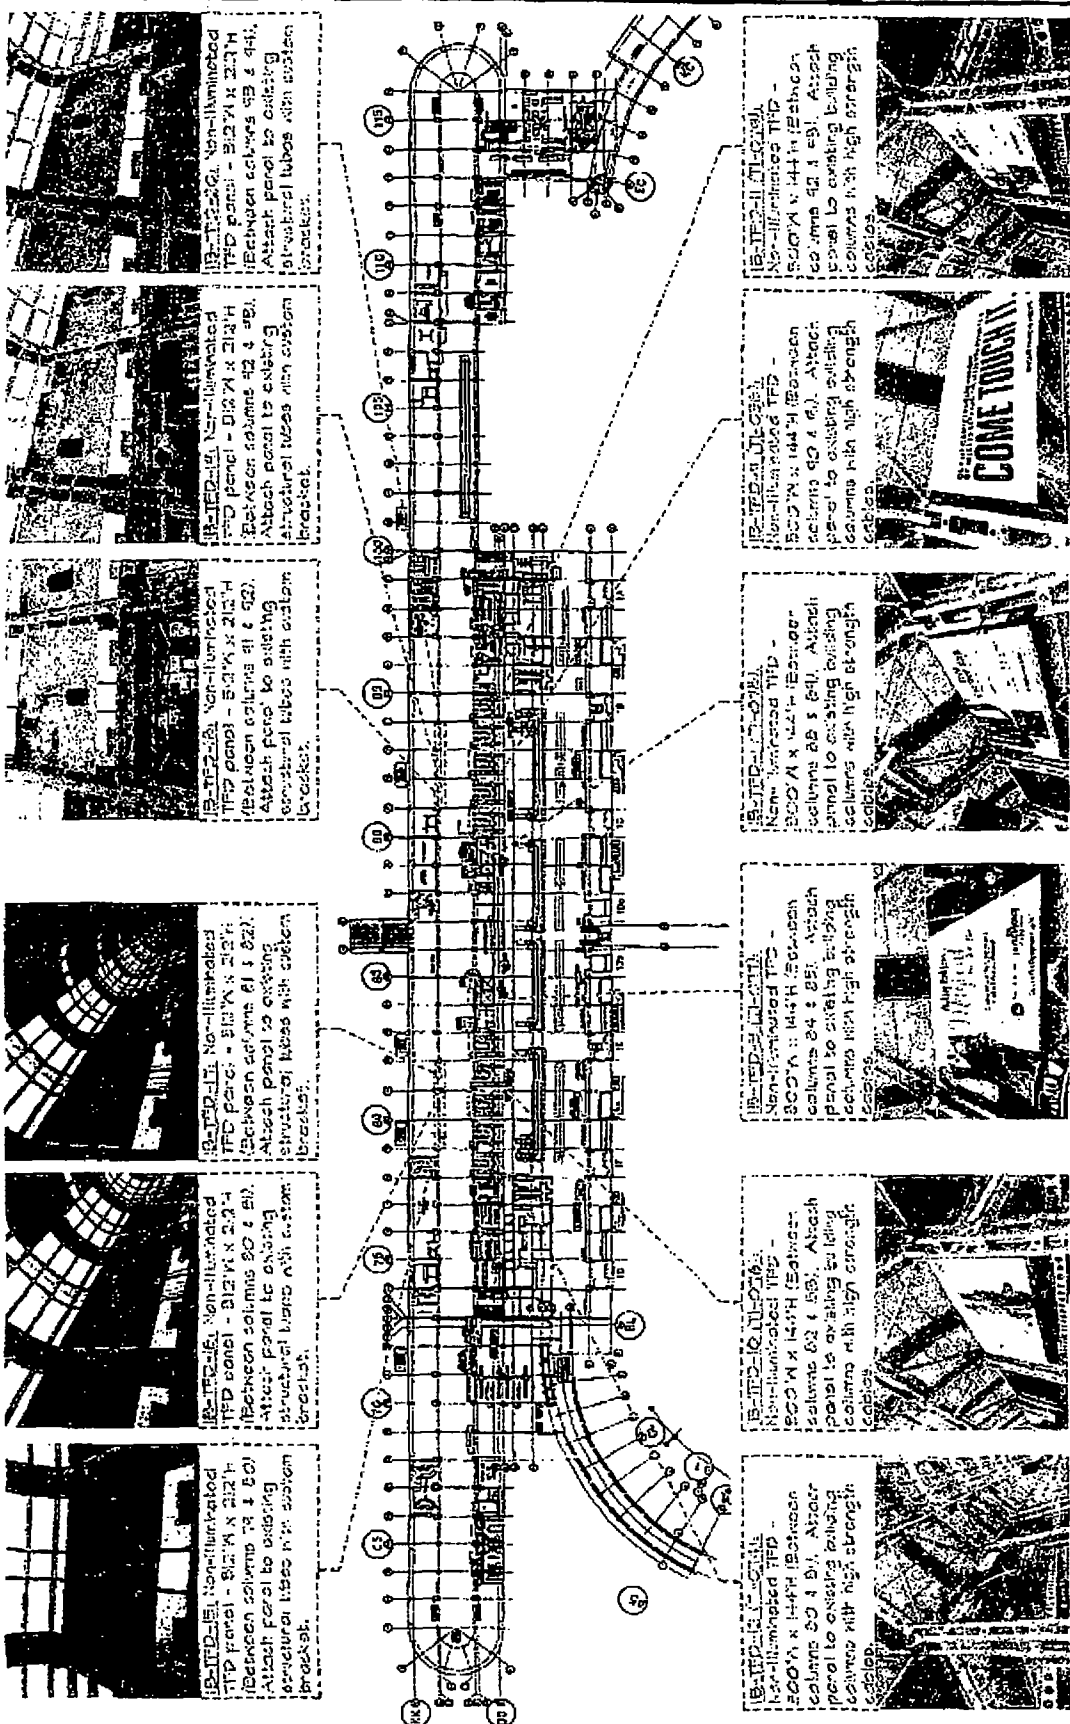

1A-TFD-11 Non-Illuminated TFD panel - 812'W x 212'H. Attach panel to existing structural tubes with custom brackets.

1B-TFD-12 Non-Illuminated TFD panel - 812'W x 212'H. Attach panel to existing structural tubes with custom brackets.

1C-TFD-13 Non-Illuminated TFD panel - 812'W x 212'H. Attach panel to existing structural tubes with custom brackets.

1D-TFD-14 Non-Illuminated TFD panel - 812'W x 212'H. Attach panel to existing structural tubes with custom brackets.

1E-TFD-15 Non-Illuminated TFD panel - 812'W x 212'H. Attach panel to existing structural tubes with custom brackets.

1F-TFD-16 Non-Illuminated TFD panel - 812'W x 212'H. Attach panel to existing structural tubes with custom brackets.

1G-TFD-17 Non-Illuminated TFD panel - 812'W x 212'H. Attach panel to existing structural tubes with custom brackets.

1A-TFD-11 (11-026) Non-Illuminated TFD - 800'W x 144'H (Between columns 14 & 15). Attach panel to existing building columns with high strength cables.

1B-TFD-12 (12-026) Non-Illuminated TFD - 800'W x 144'H (Between columns 16 & 17). Attach panel to existing building columns with high strength cables.

1C-TFD-13 (13-026) Non-Illuminated TFD - 800'W x 144'H (Between columns 18 & 19). Attach panel to existing building columns with high strength cables.

1D-TFD-14 (14-026) Non-Illuminated TFD - 800'W x 144'H (Between columns 20 & 21). Attach panel to existing building columns with high strength cables.

1E-TFD-15 (15-026) Non-Illuminated TFD - 800'W x 144'H (Between columns 22 & 23). Attach panel to existing building columns with high strength cables.

1F-TFD-16 (16-026) Non-Illuminated TFD - 800'W x 144'H (Between columns 24 & 25). Attach panel to existing building columns with high strength cables.

1G-TFD-17 (17-026) Non-Illuminated TFD - 800'W x 144'H (Between columns 26 & 27). Attach panel to existing building columns with high strength cables.



LOCATION PLAN - TERMINAL I CONCOURSE B - Upper Level


C-3

Sheet No:

TI-U-110

TFD

PARACHIN design studios, ltd.
940 West Adams Street, Suite 403
Chicago, Illinois 60607
PH 312.929.2260 FAX 312.929.2265
TeamLead@PCLLC.com@pccs.com

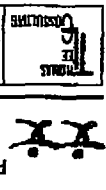

CDMA Project No: TH131113-00

PROJECT
CCA - TFD PHASE I
O'HARE INTERNATIONAL AIRPORT
11601 WEST TOWNE AVE
CHICAGO, IL 60666

CDA 100R	B7/14
REVISION	11/20/19
CDA 60R	7/20/19
AS-BUILT	01/04/16
Description:	Date:

Clear Channel Airports