



# City of Chicago



O2019-8763

Office of the City Clerk

## Document Tracking Sheet

**Meeting Date:** 11/13/2019

**Sponsor(s):** Reilly (42)

**Type:** Ordinance

**Title:** Grant(s) of privilege in public way for 162 W Hubbard Building LLC - vault

**Committee(s) Assignment:** Committee on Transportation and Public Way

ORDINANCE  
162 W. HUBBARD BUILDING, LLC  
Acct. No. 316320 - 1  
Permit No. 1142686

*Be It Ordained by the City Council of the City of Chicago:*

SECTION 1. Permission and authority are hereby given and granted to 162 W. HUBBARD BUILDING, LLC, upon the terms and subject to the conditions of this ordinance to maintain and use, as now constructed, one (1) Vault(s) under the public right-of-way adjacent to its premises known as 431 N. Wells St..

Said Vault(s) at N. Wells St measure(s):

One (1) at thirteen (13) feet in length, and four point five (4.5) feet in width for a total of fifty-eight point five (58.5) square feet.

The location of said privilege shall be as shown on prints kept on file with the Department of Business Affairs and Consumer Protection and the Office of the City Clerk.

Said privilege shall be constructed in accordance with plans and specifications approved by the Department of Transportation (Office of Underground Coordination).

This grant of privilege in the public way shall be subject to the provisions of Section 10-28-015 and all other required provisions of the Municipal Code of Chicago.


The grantee shall pay to the City of Chicago as compensation for the privilege #1142686 herein granted the sum of four hundred (\$400.00) per annum in advance.

A 25% penalty will be added for payments received after due date.

The permit holder agrees to hold the City of Chicago harmless for any damage, relocation or replacement costs associated with damage, relocation or removal of private property caused by the City performing work in the public way.

Authority herein given and granted for a period of five (5) years from and after 06/03/2019.

Alderman

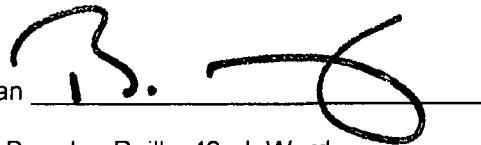A handwritten signature in black ink, appearing to be 'B. Reilly', written over a horizontal line.

Brendan Reilly 42nd Ward



**dbHMS**  
design build engineering

303 W. Erie Suite 810  
Chicago Illinois 60654  
312.915.0857 Office  
312.915.0858 Fax  
www.dbhms.com

**ABBREVIATIONS**


AFF	ABOVE FINISHED FLOOR
CB	CIRCUIT BREAKER
CCT	CIRCUIT
E	EXISTING TO REMAIN
F	FUTURE
GFI	GROUND FAULT INTERRUPTER
GRD	GROUND
HP	HORSEPOWER
JB	JUNCTION BOX
KW	KILOWATT
MCB	MAIN CIRCUIT BREAKER
MLO	MAIN LUGS ONLY
N	NEW
NIC	NOT IN CONTRACT
NL	NEW EQUIPMENT LOCATION
NIS	NOT TO SCALE
PML	PANEL
R	EXISTING TO BE REMOVED
RL	RELOCATE
WP	WEATHERPROOF

**KEY NOTES:**

1. CUSTOM FIT NEW 100A-3P C.B. EXISTING SPACE AS REQUIRED. PROVIDE 2" AIR BREAKERS TO PROTECT 1" AIR SPACE FOR NEW C.B. EXTEND CONDUIT & WIRE AS REQUIRED.
2. REUSE EXISTING CONDUIT WHERE FEASIBLE.
3. RELOCATE ALL CIRCUIT BREAKERS ON PANEL PP-1 TO NEW PANEL PP-1. EXTEND CONDUIT AND WIRE AS REQUIRED FOR A COMPLETE INSTALLATION.

**NOTES:**  
ELECTRICAL DISTRIBUTION EQUIPMENT AMPERE INTERRUPT CURRENT (AIC) SHALL EXCEED ACTUAL AVAILABLE RATINGS TO BE OBTAINED FROM CATALOG. ELECTRICAL CONTRACTOR SHALL SUBMIT A I.C. STUDY TO ENSURE NEW EQUIPMENT RATINGS EXCEEDS AVAILABLE UTILITY FAULT CURRENT FOR ALL NEW DISTRIBUTION EQUIPMENT.

**GENERAL NOTE:**  
ELECTRICAL CONTRACTOR TO PROVIDE WRITTEN AS-BUILT DRAWING REFLECTING CON. CONDITION IN AS-BUILT INCLUDING, BUT NOT LIMITED TO CURRENT STATE, VULNERABILITY, ETC.

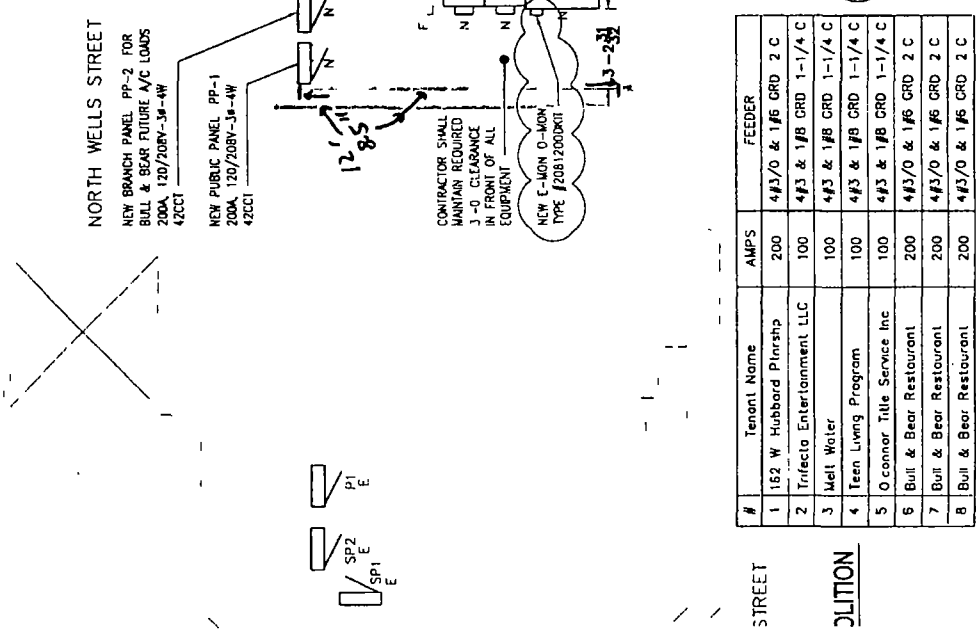

DRAWING TITLE  
**431 N WELLS ST  
ELECTRICAL SERVICE  
UPGRADE**

APPROVED BY SDV  
DRAWN BY KAB  
DATE 2009 09 21  
ISSUANCE TO COMED ANALYST 09 21 09  
ISSUANCE FOR CONSTRUCTION 12 09 10  
ADDENDUM #1 12 29 10  
ADDENDUM #2 02 14 11

ACAD FILE 162 W Hubbard Electl Service Upgrade