



City of Chicago



Or2017-134

Office of the City Clerk

Document Tracking Sheet

Meeting Date:	3/29/2017
Sponsor(s):	Napolitano (41)
Type:	Order
Title:	Issuance of permits for sign(s)/signboard(s) at 11601 W Touhy Ave - Sign 7
Committee(s) Assignment:	Committee on Zoning, Landmarks and Building Standards

Committee on Zoning, Landmarks and Building Standards

(signs)

ORDERED, That the Commissioner of Buildings is hereby directed to issue 1 sign permit to:


Grate Signs
4044 W McDonough
Joliet, IL 60431

For the erection of one (1) awning sign over 24 feet in height and/or over 100 square feet (in area of one face) at:


11601 W Touhy
Chicago, IL 60666

#1	Dimensions: length <u>26 feet</u>	height <u>17 feet 8 inches</u>
	Height above grade/roof to top of sign	<u>38 feet</u>
	Total Square Foot Area	<u>459 square feet</u>
	Elevation	<u>East</u>

Such sign shall comply with all applicable provisions of TITLE 17 of the Chicago Zoning Ordinance and all other applicable provisions of the Municipal Code of the City of Chicago governing the construction and maintenance of outdoor signs, signboards and structures.

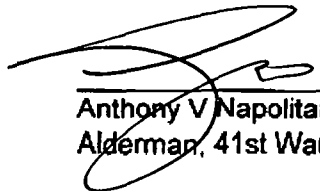 41st

Anthony V. Napolitano
Alderman, 41st Ward

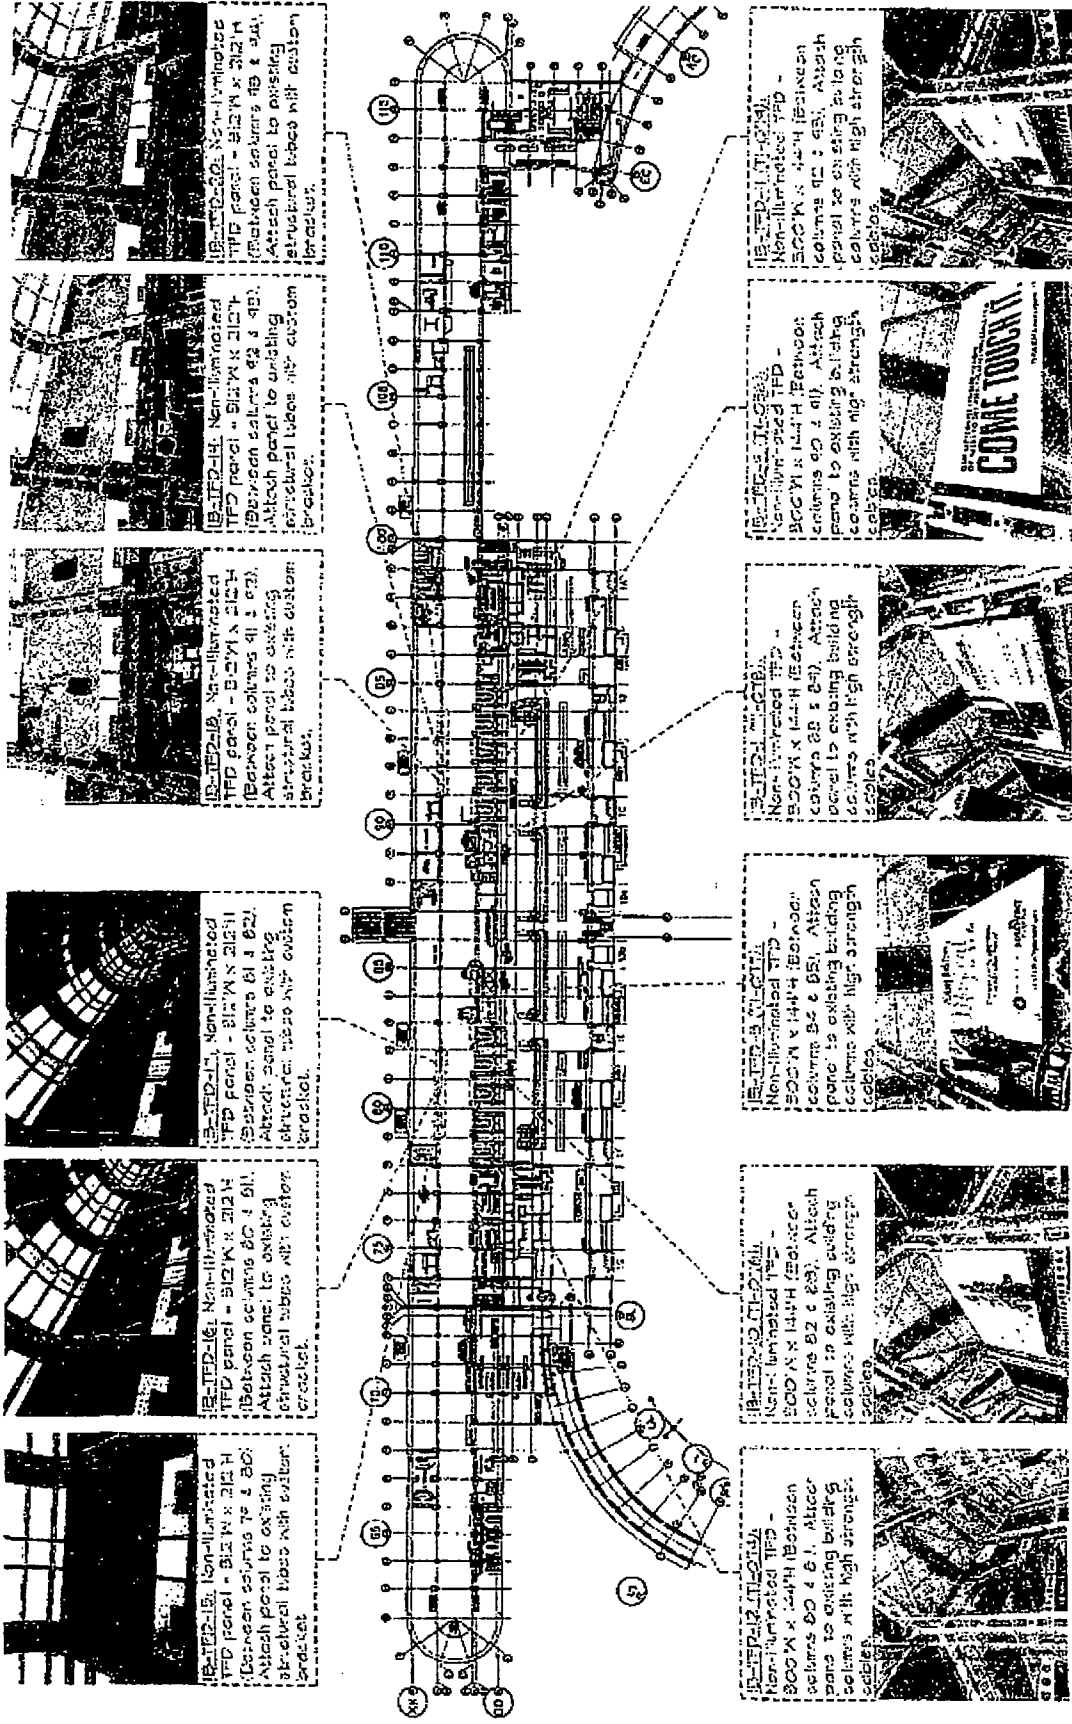

10-TFD-10: Non-Illuminated TFD panel - 512' M x 212' M (Between columns 10 & 20). Attach panel to existing structural tubes with custom brackets.

11-TFD-11: Non-Illuminated TFD panel - 512' M x 212' M (Between columns 11 & 21). Attach panel to existing structural tubes with custom brackets.

12-TFD-12: Non-Illuminated TFD panel - 512' M x 212' M (Between columns 12 & 22). Attach panel to existing structural tubes with custom brackets.

13-TFD-13: Non-Illuminated TFD panel - 512' M x 212' M (Between columns 13 & 23). Attach panel to existing structural tubes with custom brackets.

14-TFD-14: Non-Illuminated TFD panel - 512' M x 212' M (Between columns 14 & 24). Attach panel to existing structural tubes with custom brackets.

15-TFD-15: Non-Illuminated TFD panel - 512' M x 212' M (Between columns 15 & 25). Attach panel to existing structural tubes with custom brackets.

20-TFD-20: Non-Illuminated TFD panel - 300' M x 144' M (Between columns 20 & 21). Attach panel to existing building columns with high strength cables.

21-TFD-21: Non-Illuminated TFD panel - 300' M x 144' M (Between columns 21 & 22). Attach panel to existing building columns with high strength cables.

22-TFD-22: Non-Illuminated TFD panel - 300' M x 144' M (Between columns 22 & 23). Attach panel to existing building columns with high strength cables.

23-TFD-23: Non-Illuminated TFD panel - 300' M x 144' M (Between columns 23 & 24). Attach panel to existing building columns with high strength cables.

24-TFD-24: Non-Illuminated TFD panel - 300' M x 144' M (Between columns 24 & 25). Attach panel to existing building columns with high strength cables.

25-TFD-25: Non-Illuminated TFD panel - 300' M x 144' M (Between columns 25 & 26). Attach panel to existing building columns with high strength cables.

PARACHIN design studios, ltd.
140 West Adams Street, Suite 403
Chicago, Illinois 60607
Tel: 312-829-2260 Fax: 312-829-2265
314.544.5635
Tomkins@TCLLC.com




CDA Project No: TH131113-00

PROJECT
O'HARE INTERNATIONAL AIRPORT
11601 WEST COURT AVE
CHICAGO, IL 60666
Clear Channel Airports

CDA 100%	9/7/14
REVISION	11/20/15
CDA 60%	7/30/15
AS-BUILT	01/04/16
Description:	Date:

Sheet No: C-3
TI-UTD

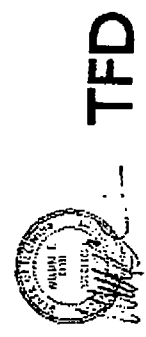

LOCATION PLAN - TERMINAL | CONCOURSE B - Upper Level
NTS

TFD