



City of Chicago



Or2017-139

Office of the City Clerk

Document Tracking Sheet

Meeting Date:	3/29/2017
Sponsor(s):	Napolitano (41)
Type:	Order
Title:	Issuance of permits for sign(s)/signboard(s) at 11601 W Touhy Ave - Sign 12
Committee(s) Assignment:	Committee on Zoning, Landmarks and Building Standards

Committee on Zoning, Landmarks and Building Standards

(signs)

ORDERED, That the Commissioner of Buildings is hereby directed to issue 1 sign permit to:


Grate Signs
4044 W McDonough
Joliet, IL 60431

For the erection of one (1) awning sign over 24 feet in height and/or over 100 square feet (in area of one face) at:


11601 W Touhy
Chicago, IL 60666

#1	Dimensions: length <u>25 feet</u>	height <u>12 feet</u>
	Height above grade/roof to top of sign	<u>32 feet</u>
	Total Square Foot Area	<u>300 square feet</u>
	Elevation	<u>West</u>

Such sign shall comply with all applicable provisions of TITLE 17 of the Chicago Zoning Ordinance and all other applicable provisions of the Municipal Code of the City of Chicago governing the construction and maintenance of outdoor signs, signboards and structures.

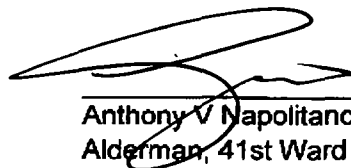 2/1/54

Anthony V Napolitano
Alderman, 41st Ward

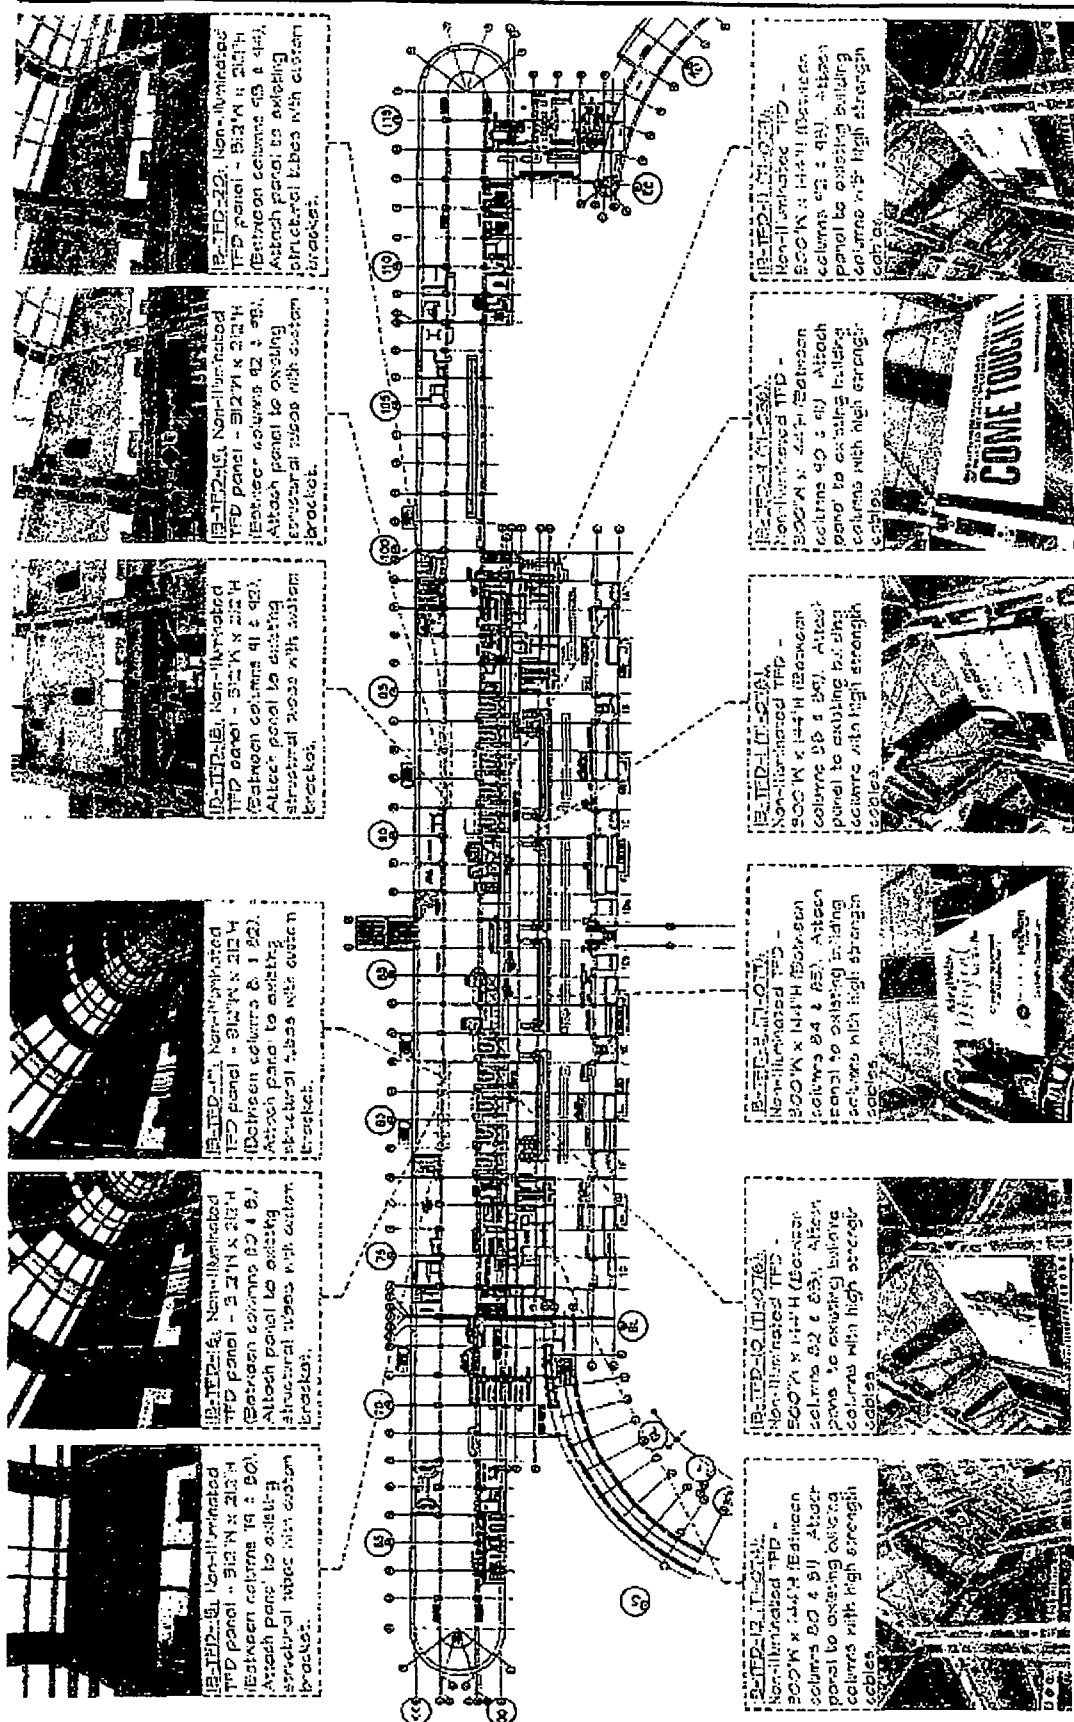

PARACHIN design studios, ltd.
 940 west aldrich street, suite 407
 CHICAGO, ILLINOIS 60607
 PH 312-407-2760 FAX 312-429-2765
 TomLear@MCLLC.artschool.com
 314.541.5635

CDA Project No: TH131113-00

Clear Channel Airports
 CHICAGO, IL 60666
 O'HARE INTERNATIONAL AIRPORT
 11601 WEST TOWNE AVE.
 PROJECT CCA - TFD, PHASE I

CDA 100%	8/7/14
REVISION	11/20/19
CDA 60%	7/30/19
AS-BUILT	07/04/16
Description:	Date:

Sheet No: C-3
 TITLED



LOCATION PLAN - TERMINAL 1 CONCOURSE B - Upper Level

NIS

TFD