



City of Chicago



Or2017-127

Office of the City Clerk

Document Tracking Sheet

Meeting Date:	3/29/2017
Sponsor(s):	Napolitano (41)
Type:	Order
Title:	Issuance of permits for sign(s)/signboard(s) at 11601 W Touhy Ave - Application No. 100695288
Committee(s) Assignment:	Committee on Zoning, Landmarks and Building Standards

CITY COUNCIL
COMMITTEE ON ZONING, LANDMARKS AND BUILDING STANDARDS

COUNCIL ORDER

RE: Approval of sign over 100 square feet in area or over 24 feet above grade

ORDERED, that the City Council hereby approves the following sign application submitted by:

Applicant*: City of Chicago - Dept. of Aviation

(* The Applicant is the owner of the real property or the business tenant of the real property. Do not list the sign contractor, sign erector, sign company or advertising entity in the above space.)

This Order approves the following sign in accordance with Municipal Code of Chicago Section 13-20-680:

Address of Sign: 11601 W. Touhy Chicago, IL 60646

Zoning District: APD

DOB Sign Permit Application #: 100695288

Sign Details:

1. On-premise OR Off-premise

2. Static sign OR Dynamic-image display sign

3. Number of sign faces 1

4. Projecting over the public way NO (Yes or No) If yes, Public Way Use #: _____

5. Dimensions: Length 24 feet 0 inches Height 6 feet 0 inches

Total square feet in area: 144 feet 0 inches

6. Height above grade: 26 feet 0 inches

7. Elevation (side of building or lot where the sign will be erected): West

8. Name of Sign Contractor/Erector: Grate Signs

To be legal, such sign shall comply with all provisions of Title 17 of the Chicago Municipal Code ("Zoning Ordinance") and all other provisions of the Municipal Code governing the permitting, construction and maintenance and removal of signs and sign structures. Failure of the applicant and the applicant's successors to comply shall be grounds for invalidation or revocation of the sign permit.


Alderman

41ST
Ward

PARACLIIM design studios, led.
 900 WEST TOLSON AVE, SUITE 400
 CHICAGO, ILLINOIS 60666
 PH: 312.279.2200 FAX: 312.279.2205
 314.541.5635
 TOLLFREE@MILLICENTERSYSTEMS.COM




Project No: T11J11.00

PROJECT
 CCA - TFD, PHASE I
 O'HARE INTERNATIONAL AIRPORT
 1160 WEST TOLSON AVE,
 CHICAGO, IL 60666

CDA 100%	B77.4
REVISION	11/20/15
CDA 100%	7/30/15
AS-BUILT	07/04/16
Description:	Date:

Sheet No: C-4
 T11J11.00

TFD

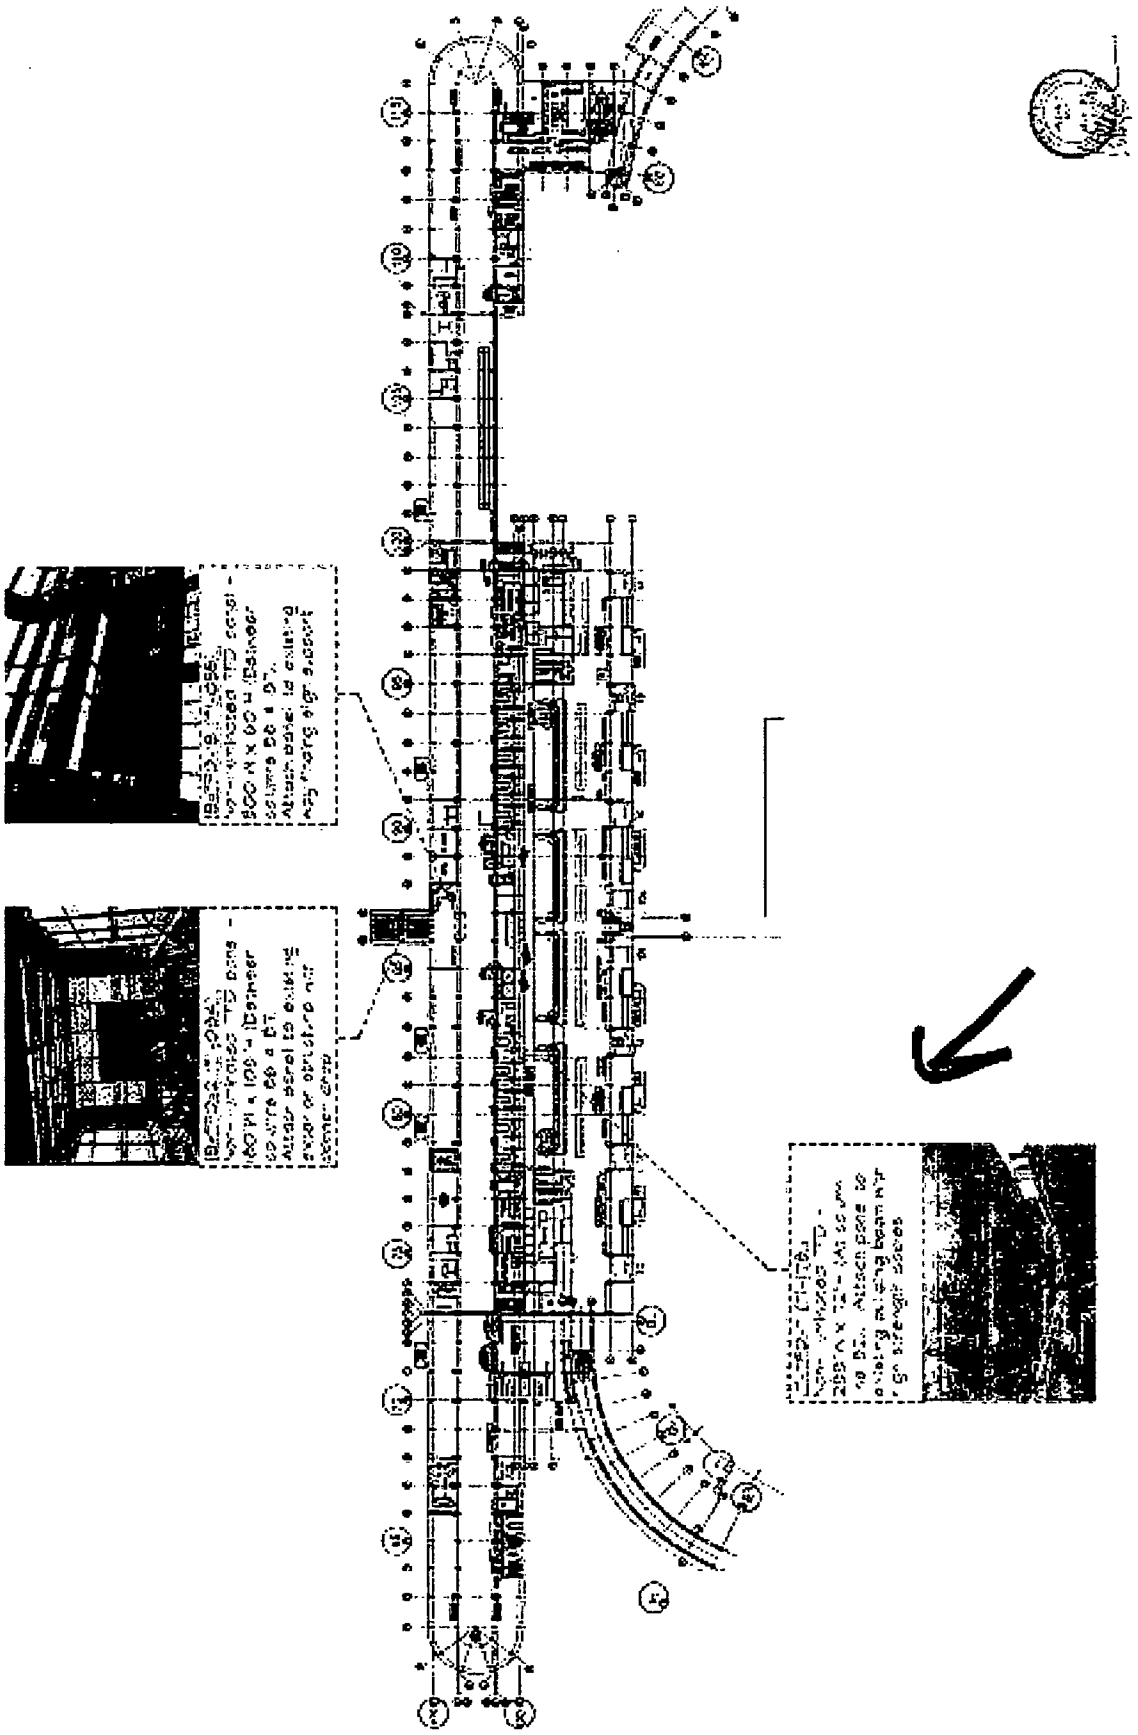

15'-0" x 15'-0" (15'-0" x 15'-0")
 15'-0" x 15'-0" (15'-0" x 15'-0")
 8'-0" x 6'-0" (8'-0" x 6'-0")
 Columns 26 & 27
 Attach panel to existing
 ceiling structure

LOCATION PLAN - TERMINAL | CONCOURSE B - Upper Level

