



City of Chicago



O2014-3030

Office of the City Clerk

Document Tracking Sheet

Meeting Date:	4/2/2014
Sponsor(s):	Reilly (42)
Type:	Ordinance
Title:	Awning(s) for Chipotle
Committee(s) Assignment:	Committee on Transportation and Public Way

ORDINANCE
CHIPOTLE
Acct. No. 22633 - 35
Permit No. 1110752

Be It Ordained by the City Council of the City of Chicago:

SECTION 1. Permission and authority are hereby given and granted to CHIPOTLE, upon the terms and subject to the conditions of this ordinance to construct, install, maintain and use four (4) Awning(s) projecting over the public right-of-way adjacent to its premises known as 311 S. Wacker Dr..

Said Awning(s) at S. Franklin Street measure(s):

Three (3) at six point one seven (6.17) feet in length, and three point three three (3.33) feet in width for a total of sixty-one point six four (61.64) square feet.

One (1) at seven point six seven (7.67) feet in length, and three point three three (3.33) feet in width for a total of twenty-five point five four (25.54) square feet.

The location of said privilege shall be as shown on prints kept on file with the Department of Business Affairs and Consumer Protection and the Office of the City Clerk.

Said privilege shall be constructed in accordance with plans and specifications approved by the Zoning Department - Signs.

This grant of privilege in the public way shall be subject to the provisions of Section 10-28-015 and all other required provisions of the Municipal Code of Chicago.

The grantee shall pay to the City of Chicago as compensation for the privilege #1110752 herein granted the sum of one hundred seventy-five (\$175.00) per annum in advance.

A 25% penalty will be added for payments received after due date.

The permit holder agrees to hold the City of Chicago harmless for any damage, relocation or replacement costs associated with damage, relocation or removal of private property caused by the City performing work in the public way.

Authority herein given and granted for a period of five (5) years from and after Date of Passage.

Alderman _____


Brendan Reilly 42nd Ward

ADCON

Advertising Concepts Inc.
3725 Canal Drive
Fort Collins, CO 80524
970 484 3637
www.adconsigns.com
This document and data have been created by ADCON. It is the property of ADCON and is not to be used for any other purpose without the written consent of ADCON. All rights reserved.

Design Proposal for:
Chipotle Mexican Grill
311 S. Wacker

Sign Type _____ Various
Date: May 10, 2013
Drawn by: Step W.
Account Manager: Rob K.
Project Manager:
Design Estimate #: 27940
File Name: East Elevation

Client Approval

Project Name: _____

Date: _____


NOTE: Please review all of the changes you make on this drawing and re-submit to ADCON. ADCON will not be responsible for any changes you make on this drawing. All changes will need to be approved by ADCON before we can proceed.

Approved
 Approved As Noted
 Revise And Resubmit

Production Mgr Approval	Date
Project Mgr Approval	Date
Account Mgr Approval	Date
Field Mgr Approval	Date

Revision Notes:
Add or replace 3D drawings

Seq. No. _____ ★
W.O. No. _____
Rev. No. B Date: 5-15-13
By: Step
Sheet No. 1.0

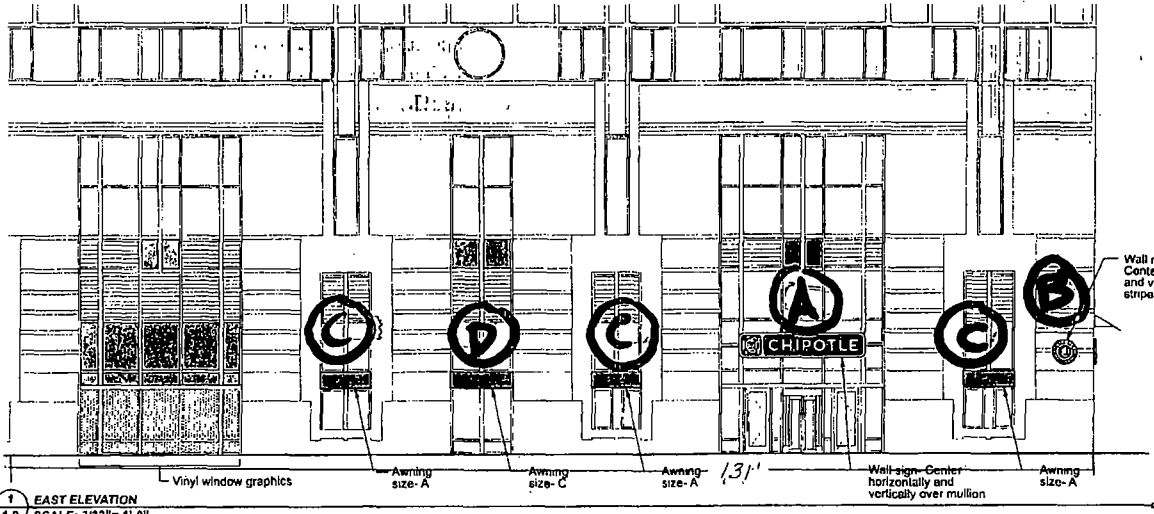

1 EAST ELEVATION
SCALE: 3/32" = 1'-0"

Wall medallion - Center horizontally and vertically over stripe

Vinyl window graphics

Awning size-A

Awning size-C

Awning size-A

131'

Wall sign - Center horizontally and vertically over mullion

Awning size-A

All artwork created or prepared by ADCON is the property of ADCON and is not to be used for any other project without the written consent of ADCON.