



City of Chicago



Or2017-124

Office of the City Clerk Document Tracking Sheet

Meeting Date:	3/29/2017
Sponsor(s):	Napolitano (41)
Type:	Order
Title:	Issuance of permits for sign(s)/signboard(s) at 11601 W Touhy Ave - Application No. 100695284
Committee(s) Assignment:	Committee on Zoning, Landmarks and Building Standards

CITY COUNCIL
COMMITTEE ON ZONING, LANDMARKS AND BUILDING STANDARDS

COUNCIL ORDER

RE: Approval of sign over 100 square feet in area or over 24 feet above grade

ORDERED, that the City Council hereby approves the following sign application submitted by:

Applicant*: City of Chicago - Dept. of Aviation

(* The Applicant is the owner of the real property or the business tenant of the real property. Do not list the sign contractor, sign erector, sign company or advertising entity in the above space.)

This Order approves the following sign in accordance with Municipal Code of Chicago Section 13-20-680:

Address of Sign: 11601 W. Touhy Chicago, IL 60646


Zoning District: APD

DOB Sign Permit Application #: 100695284

Sign Details:

1. On-premise OR Off-premise
2. Static sign OR Dynamic-image display sign
3. Number of sign faces 1
4. Projecting over the public way No (Yes or No) If yes, Public Way Use #: _____
5. Dimensions: Length 15 feet 0 inches Height 9 feet 0 inches
Total square feet in area: 135 feet 0 inches
6. Height above grade: 29 feet 0 inches
7. Elevation (side of building or lot where the sign will be erected): West
8. Name of Sign Contractor/Erector: Grate Signs


To be legal, such sign shall comply with all provisions of Title 17 of the Chicago Municipal Code ("Zoning Ordinance") and all other provisions of the Municipal Code governing the permitting, construction and maintenance and removal of signs and sign structures. Failure of the applicant and the applicant's successors to comply shall be grounds for invalidation or revocation of the sign permit.

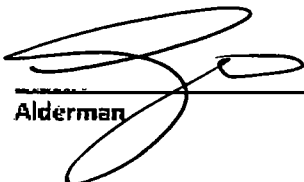
Alderman

41
Ward

1. All metal work shall be non-flammable of this level.
 2. Backdrop to be 10' x 10' with 1" x 1" mesh with 2" x 2" mesh.

1. All metal work shall be non-flammable of this level.
 2. Backdrop to be 10' x 10' with 1" x 1" mesh with 2" x 2" mesh.

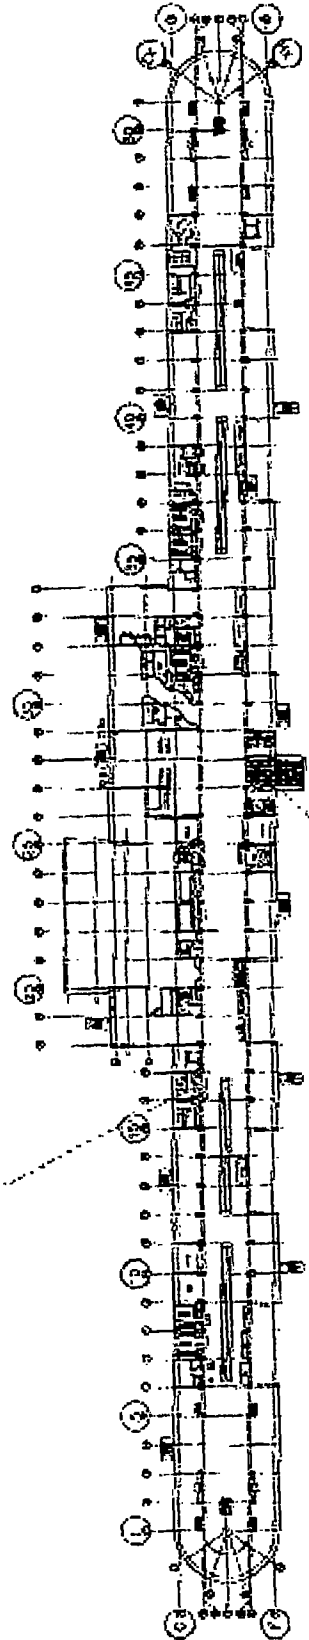

LOCATION PLAN - TERMINAL I CONOURSE C - Upper Level

NTS

PARACHTIN design studios, led
 400 West Madison Street, Suite 1100
 Chicago, Illinois 60607
 Tel: 312-467-2260 Fax: 312-467-2261



CON Project No: 07-113
 DATE: 11/13/07

PROJECT
 O'HARE INTERNATIONAL AIRPORT
 1100 WEST TOWHY AVE.
 CHICAGO, IL 60646

CDA 100R	9/11/04
REVISION	11/22/07
CDA 100R	11/20/07
AS-BUILT	01/04/16
Description:	
Date:	

Sheet No: C-5
 Title: TFD

314.541.5635
 100 West Madison Street, Suite 1100
 Chicago, Illinois 60607
 Tel: 312-467-2260 Fax: 312-467-2261



CON Project No: 07-113
 DATE: 11/13/07

PROJECT
 O'HARE INTERNATIONAL AIRPORT
 1100 WEST TOWHY AVE.
 CHICAGO, IL 60646

CDA 100R	9/11/04
REVISION	11/22/07
CDA 100R	11/20/07
AS-BUILT	01/04/16
Description:	
Date:	

Sheet No: C-5
 Title: TFD