



City of Chicago



Or2017-128

Office of the City Clerk

Document Tracking Sheet

Meeting Date:	3/29/2017
Sponsor(s):	Napolitano (41)
Type:	Order
Title:	Issuance of permits for sign(s)/signboard(s) at 11601 W Touhy Ave - Sign 1
Committee(s) Assignment:	Committee on Zoning, Landmarks and Building Standards

Committee on Zoning, Landmarks and Building Standards

(signs)

ORDERED, That the Commissioner of Buildings is hereby directed to issue 1 sign permit to:


Grate Signs
4044 W McDonough
Joliet, IL 60431

For the erection of one (1) awning sign over 24 feet in height and/or over 100 square feet (in area of one face) at:

11601 W Touhy
Chicago, IL 60666

#1	Dimensions: length <u>25 feet</u>	height <u>12 feet</u>
	Height above grade/roof to top of sign	<u>32 feet</u>
	Total Square Foot Area	<u>300 square feet</u>
	Elevation	<u>West</u>

Such sign shall comply with all applicable provisions of TITLE 17 of the Chicago Zoning Ordinance and all other applicable provisions of the Municipal Code of the City of Chicago governing the construction and maintenance of outdoor signs, signboards and structures.

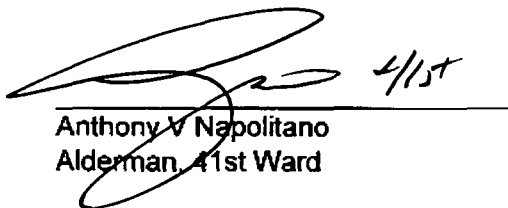 4/15
Anthony V Napolitano
Alderman, 41st Ward


LOCATION PLAN - TERMINAL 1 CONCOURSE B - Upper Level



TFD

TI-11-TRD

C-3

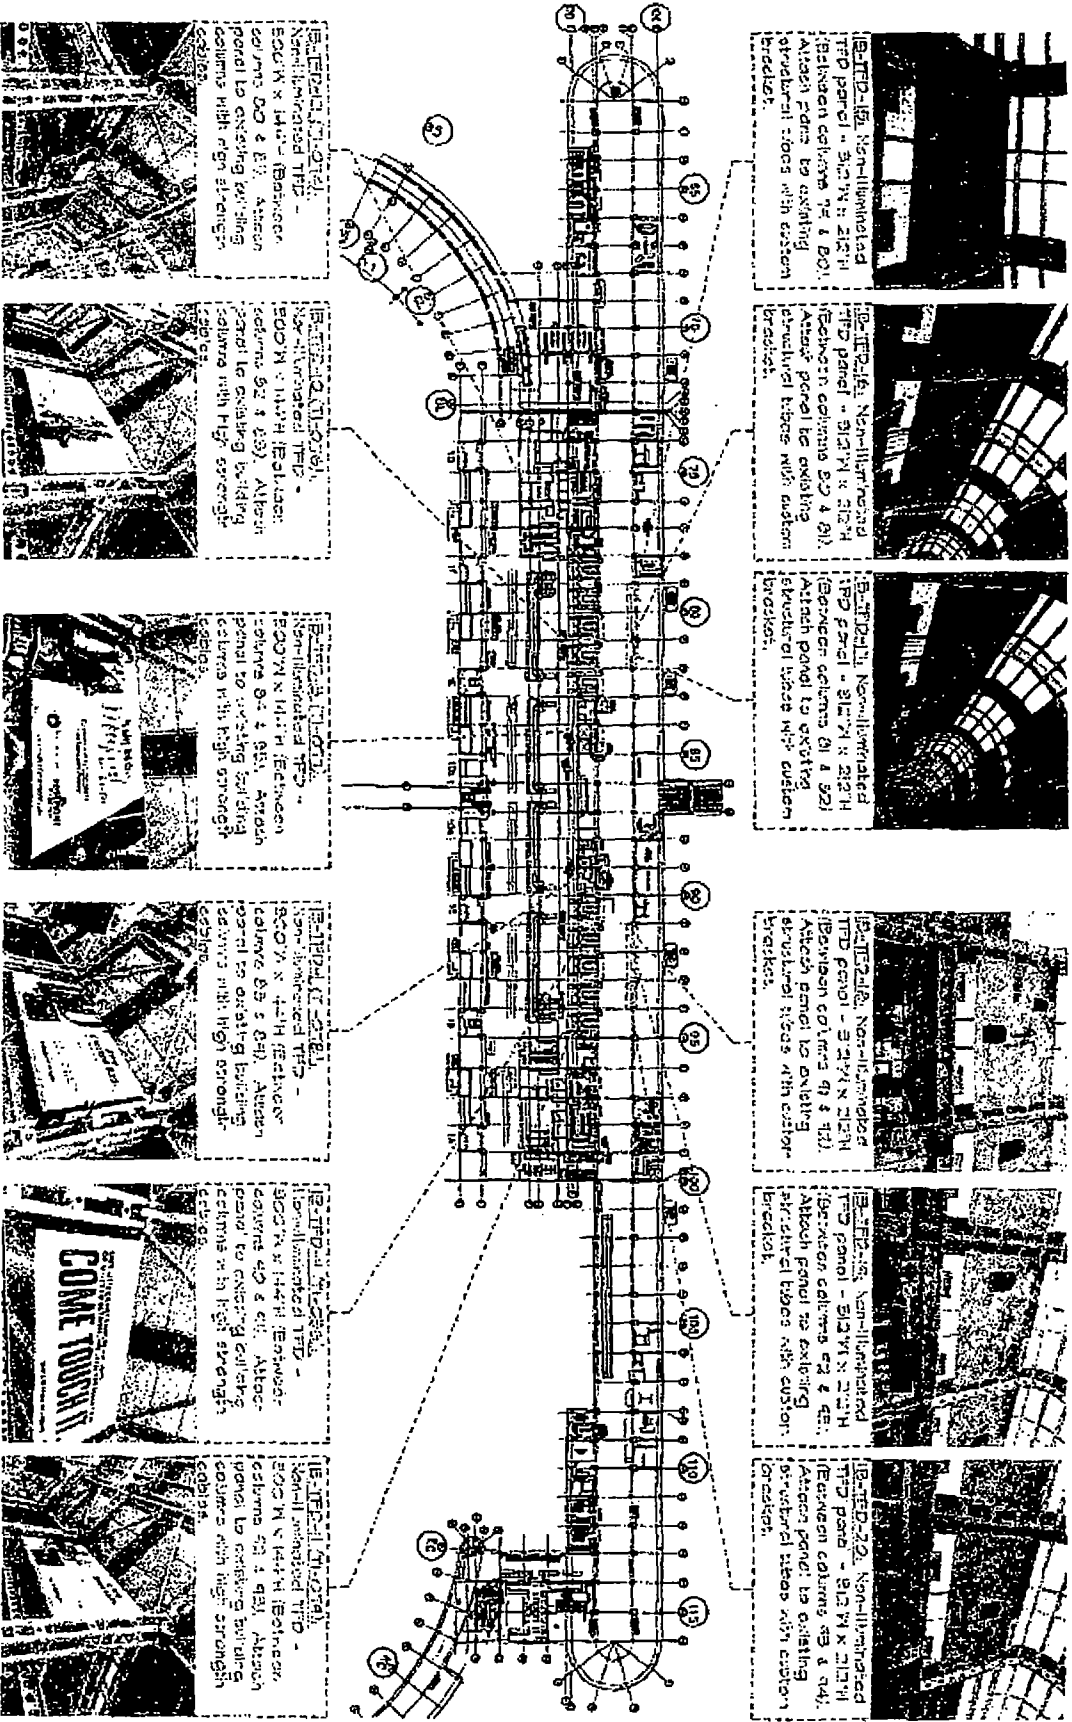

1E-TFD-15a Non-Illuminated TFD panel - 312" W x 212" H Between columns 15 & 16. Attach panel to existing structural ribs with custom brackets.

1E-TFD-15b Non-Illuminated TFD panel - 312" W x 212" H Between columns 16 & 17. Attach panel to existing structural ribs with custom brackets.

1E-TFD-15c Non-Illuminated TFD panel - 312" W x 212" H Between columns 17 & 18. Attach panel to existing building columns with high strength cables.

1E-TFD-15d Non-Illuminated TFD panel - 312" W x 212" H Between columns 18 & 19. Attach panel to existing building columns with high strength cables.

1E-TFD-15e Non-Illuminated TFD panel - 312" W x 212" H Between columns 19 & 20. Attach panel to existing building columns with high strength cables.

1E-TFD-15f Non-Illuminated TFD panel - 312" W x 212" H Between columns 20 & 21. Attach panel to existing building columns with high strength cables.

1E-TFD-15g Non-Illuminated TFD panel - 312" W x 212" H Between columns 21 & 22. Attach panel to existing structural ribs with custom brackets.

1E-TFD-15h Non-Illuminated TFD panel - 312" W x 212" H Between columns 22 & 23. Attach panel to existing structural ribs with custom brackets.

1E-TFD-15i Non-Illuminated TFD panel - 312" W x 212" H Between columns 23 & 24. Attach panel to existing structural ribs with custom brackets.

1E-TFD-15j Non-Illuminated TFD panel - 312" W x 212" H Between columns 24 & 25. Attach panel to existing structural ribs with custom brackets.

1E-TFD-15k Non-Illuminated TFD panel - 312" W x 212" H Between columns 25 & 26. Attach panel to existing structural ribs with custom brackets.

1E-TFD-15l Non-Illuminated TFD panel - 312" W x 212" H Between columns 26 & 27. Attach panel to existing structural ribs with custom brackets.

1E-TFD-15m Non-Illuminated TFD panel - 312" W x 212" H Between columns 27 & 28. Attach panel to existing structural ribs with custom brackets.

1E-TFD-15n Non-Illuminated TFD panel - 312" W x 212" H Between columns 28 & 29. Attach panel to existing structural ribs with custom brackets.

1E-TFD-15o Non-Illuminated TFD panel - 312" W x 212" H Between columns 29 & 30. Attach panel to existing structural ribs with custom brackets.

1E-TFD-15p Non-Illuminated TFD panel - 312" W x 212" H Between columns 30 & 31. Attach panel to existing structural ribs with custom brackets.

1E-TFD-15q Non-Illuminated TFD panel - 312" W x 212" H Between columns 31 & 32. Attach panel to existing structural ribs with custom brackets.

1E-TFD-15r Non-Illuminated TFD panel - 312" W x 212" H Between columns 32 & 33. Attach panel to existing structural ribs with custom brackets.

PROJECT
CCA - TFD, PHASE I
OHARE INTERNATIONAL AIRPORT
11601 WEST TOLUHY AVE.
CHICAGO, IL 60666

CCA Project No:
TH131113-00

PARACHIN design studios, ltd.
940 west adams street, suite 401
chicago, illinois 60607
tel 312.629.2260 fax 312.629.2265

314.541.5635
TamLee@TLCLLC.com@microsoft.com

CDR 100%	9/7/14
REVISION	1/20/15
CDR 60%	7/20/15
AS-BUILT	01/04/16
Description:	Date:

Sheet No: