



City of Chicago



O2014-7330

Office of the City Clerk

Document Tracking Sheet

Meeting Date:	9/10/2014
Sponsor(s):	Reilly (42)
Type:	Ordinance
Title:	Grant(s) of privilege in public way for JBC/155 Development
Committee(s) Assignment:	Committee on Transportation and Public Way

ORDINANCE
JBC/155 DEVELOPMENT
Acct. No. 315919 - 1
Permit No. 1114423

Be It Ordained by the City Council of the City of Chicago:

SECTION 1. Permission and authority are hereby given and granted to JBC/155 DEVELOPMENT, upon the terms and subject to the conditions of this ordinance to maintain and use, as now constructed, eight (8) Conduit(s) under the public right-of-way adjacent to its premises known as 155 N. Wacker Dr..

Said Conduit(s) at W. Wacker Dr measure(s):

Eight (8) at fifteen point eight three (15.83) feet in length, and three (3) feet in width for a total of three hundred seventy-nine point nine two (379.92) square feet.

The location of said privilege shall be as shown on prints kept on file with the Department of Business Affairs and Consumer Protection and the Office of the City Clerk.

Said privilege shall be constructed in accordance with plans and specifications approved by the Department of Transportation (Division of Project Development) and Department of Transportation (Office of Underground Coordination).

This grant of privilege in the public way shall be subject to the provisions of Section 10-28-015 and all other required provisions of the Municipal Code of Chicago.

The grantee shall pay to the City of Chicago as compensation for the privilege #1114423 herein granted the sum of seven hundred fifty-nine dollars and eighty-four cents (\$759.84) per annum in advance.


A 25% penalty will be added for payments received after due date.


The permit holder agrees to hold the City of Chicago harmless for any damage, relocation or replacement costs associated with damage, relocation or removal of private property caused by the City performing work in the public way.

Authority herein given and granted for a period of five (5) years from and after 07/29/2014.

Alderman _____

Brendan Reilly 42nd Ward

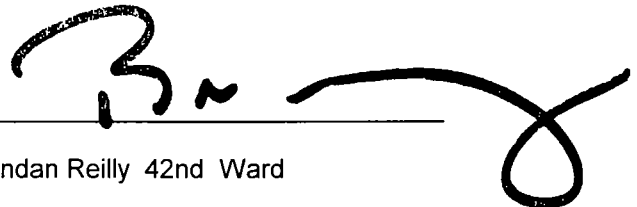A large, stylized handwritten signature in black ink, appearing to read 'B. Reilly', is written over a horizontal line. The signature is fluid and cursive, with a large loop at the end.

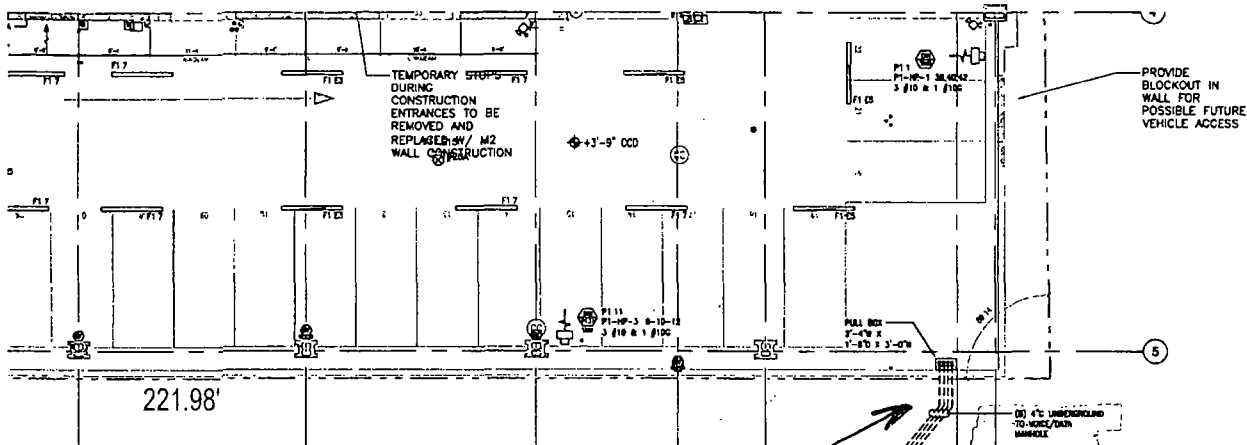

ELECTRICAL PLAN LEVEL P1
SCALE 1/8"=1'-0"

Public Way
Privilege

DESCRIPTION	QUANTITY
300 R/W T-42	11350
AT&T E-1	2540
1200A CT	1400
1200B CT	1400
SWED LWP	1000
SWED-T	1200
SWED-E1	1000

WMA JOB # 07052-00

REV	DATE	PURPOSE
1	06-30-2007	FOR PERMIT
2	08-11-2007	MEP COORDINATION
3	08-28-2007	MEP COORDINATION
4	09-18-2008	FOR CONSTRUCTION
5	07-15-2008	FOR CONSTRUCTION
6	05-27-2008	MECHANICAL REVISIONS
7	01-16-08	BULLETPROOFING
8	07-18-2008	AS-BUILT

REVISIONS

155
NORTH WACKER DRIV
The John Bann Company
One North Wacker Drive Chicago, IL 60606

DRAWING DESIGNATION
ELECTRICAL PLAN
LEVEL P1

Johnson
Electric & Technology Solutions
an ECHS Group

1000 WACKER DRIVE, CHICAGO, ILLINOIS 60606
TEL: 312.555.5555 FAX: 312.555.5555

SCALE: 1/8"=1'-0" JOB # 0507
DATE: 3-28-07 GEC DRAWING #
DRAWN BY: B. ZEMAN 0-52-205-F
CHECKED BY: M. KELLY

