



# City of Chicago



Or2017-131

Office of the City Clerk

## Document Tracking Sheet

<b>Meeting Date:</b>	3/29/2017
<b>Sponsor(s):</b>	Napolitano (41)
<b>Type:</b>	Order
<b>Title:</b>	Issuance of permits for sign(s)/signboard(s) at 11601 W Touhy Ave - Sign 4
<b>Committee(s) Assignment:</b>	Committee on Zoning, Landmarks and Building Standards

Committee on Zoning, Landmarks and Building Standards

(signs)

ORDERED, That the Commissioner of Buildings is hereby directed to issue 1 sign permit to:


Grate Signs  
4044 W McDonough  
Joliet, IL 60431


For the erection of one (1) awning sign over 24 feet in height and/or over 100 square feet (in area of one face) at:


11601 W Touhy  
Chicago, IL 60666

#1	Dimensions: length <u>26 feet</u>	height <u>17 feet 8 inches</u>
	Height above grade/roof to top of sign	<u>38 feet</u>
	Total Square Foot Area	<u>459 square feet</u>
	Elevation	<u>East</u>

Such sign shall comply with all applicable provisions of TITLE 17 of the Chicago Zoning Ordinance and all other applicable provisions of the Municipal Code of the City of Chicago governing the construction and maintenance of outdoor signs, signboards and structures.

  
Anthony V Napolitano  
Alderman, 41st Ward

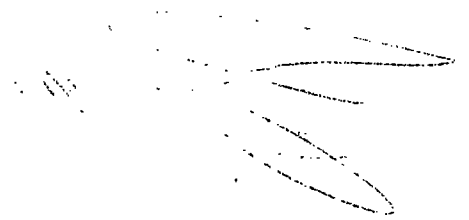

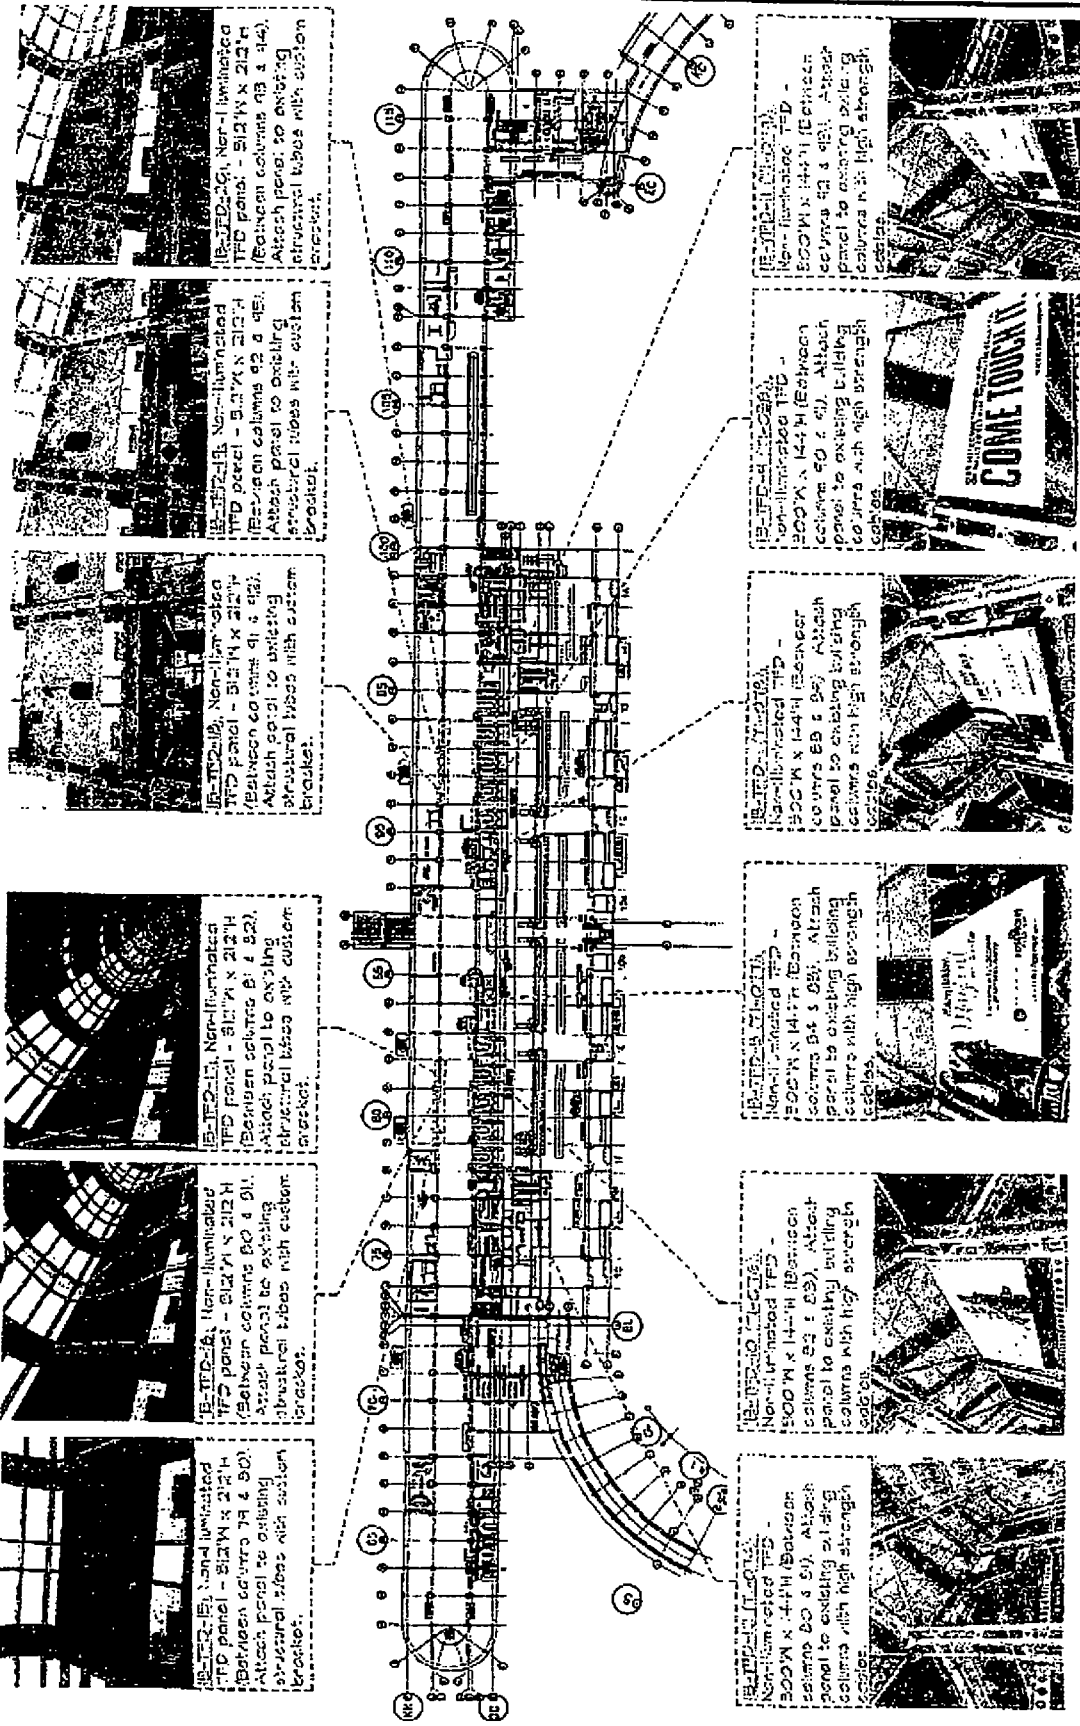

10-12-15: Non-Illuminated TFD panel - 512' M x 212' H (Between columns 79 & 80). Attach panel to existing structural tubes with custom brackets.

10-12-16: Non-Illuminated TFD panel - 512' M x 212' H (Between columns 80 & 81). Attach panel to existing structural tubes with custom brackets.

10-12-17: Non-Illuminated TFD panel - 512' M x 212' H (Between columns 81 & 82). Attach panel to existing structural tubes with custom brackets.

10-12-18: Non-Illuminated TFD panel - 512' M x 212' H (Between columns 82 & 83). Attach panel to existing structural tubes with custom brackets.

10-12-19: Non-Illuminated TFD panel - 512' M x 212' H (Between columns 83 & 84). Attach panel to existing structural tubes with custom brackets.

10-12-20: Non-Illuminated TFD panel - 512' M x 212' H (Between columns 84 & 85). Attach panel to existing structural tubes with custom brackets.

10-12-21: Non-Illuminated TFD panel - 500' M x 144' H (Between columns 80 & 81). Attach panel to existing building columns with high strength cables.

10-12-22: Non-Illuminated TFD panel - 500' M x 144' H (Between columns 82 & 83). Attach panel to existing building columns with high strength cables.

10-12-23: Non-Illuminated TFD panel - 500' M x 144' H (Between columns 84 & 85). Attach panel to existing building columns with high strength cables.

10-12-24: Non-Illuminated TFD panel - 500' M x 144' H (Between columns 86 & 87). Attach panel to existing building columns with high strength cables.

10-12-25: Non-Illuminated TFD panel - 500' M x 144' H (Between columns 88 & 89). Attach panel to existing building columns with high strength cables.

10-12-26: Non-Illuminated TFD panel - 500' M x 144' H (Between columns 90 & 91). Attach panel to existing building columns with high strength cables.

PARACHIN design studios, ltd.  
 140 York Mills Drive, Suite 101  
 North York, Ontario M2H 3M7  
 PH 416-291-2260 FAX 416-291-2265  
 314.541.5635  
 TomLee@PCLC.com tomlee@pcsl.com

CDM Project No: TM1311.13-00

PROJECT  
 CCA - TFD PHASE 1  
 CHARE INTERNATIONAL AIRPORT  
 11601 WEST TOWER AVE  
 CHICAGO, IL 60666  
 Clear Channel Airports

CDA 1008	9/7/14
REVISION	11/20/18
CDA 8028	7/20/18
AS-BUILT	01/04/18

Date: \_\_\_\_\_  
 Description: \_\_\_\_\_

Sheet No: C-3  
 TFD  
 TFD



LOCATION PLAN - TERMINAL | CONCOURSE B - Upper Level