



# City of Chicago



O2017-3405

Office of the City Clerk

## Document Tracking Sheet

<b>Meeting Date:</b>	4/19/2017
<b>Sponsor(s):</b>	Reilly (42)
<b>Type:</b>	Ordinance
<b>Title:</b>	Canopy(s) for Clare, The
<b>Committee(s) Assignment:</b>	Committee on Transportation and Public Way

ORDINANCE  
THE CLARE  
Acct. No. 372915 - 1  
Permit No. 1127501

*Be It Ordained by the City Council of the City of Chicago:*

SECTION 1. Permission and authority are hereby given and granted to THE CLARE, upon the terms and subject to the conditions of this ordinance to maintain and use, as now constructed, one (1) Canopy(s) projecting over the public right-of-way adjacent to its premises known as 55 E. Pearson St..

Said Canopy(s) at N. Rush measure(s):

One (1) at sixty-seven point seven (67.7) feet in length, and fifteen point five (15.5) feet in width for a total of one thousand forty-nine point three five (1049.35) square feet.

The location of said privilege shall be as shown on prints kept on file with the Department of Business Affairs and Consumer Protection and the Office of the City Clerk.

Said privilege shall be constructed in accordance with plans and specifications approved by the Zoning Department - Signs.

This grant of privilege in the public way shall be subject to the provisions of Section 10-28-015 and all other required provisions of the Municipal Code of Chicago.

The grantee shall pay to the City of Chicago as compensation for the privilege #1127501 herein granted the sum of ninety-two dollars and seventy cents (\$92.70) per annum in advance.


A 25% penalty will be added for payments received after due date.


The permit holder agrees to hold the City of Chicago harmless for any damage, relocation or replacement costs associated with damage, relocation or removal of private property caused by the City performing work in the public way.

Authority herein given and granted for a period of five (5) years from and after 12/14/2016.

Alderman \_\_\_\_\_

Brendan Reilly 42nd Ward

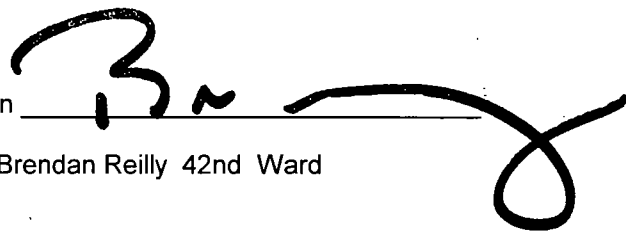
A large, stylized handwritten signature in black ink, appearing to read 'B. Reilly', is written over a horizontal line. The signature is fluid and cursive, with a large loop at the end.

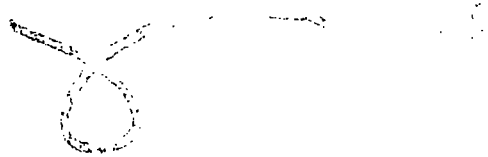

THORNTON TOMASETTI INC.






- APPROVED
- APPROVED AS NOTED
- REVISE AND RE-... II
- NOT APPROVED
- FOR RECORD ONLY

IT IS APPROVED FOR THE... WITH THE DESIGN CONCEPT... COMPLIANCE WITH... CONTRACT DOCUMENTS... THE DESIGNER'S... THE WORK... THE DESIGNER'S... THE WORK... THE DESIGNER'S... THE WORK...

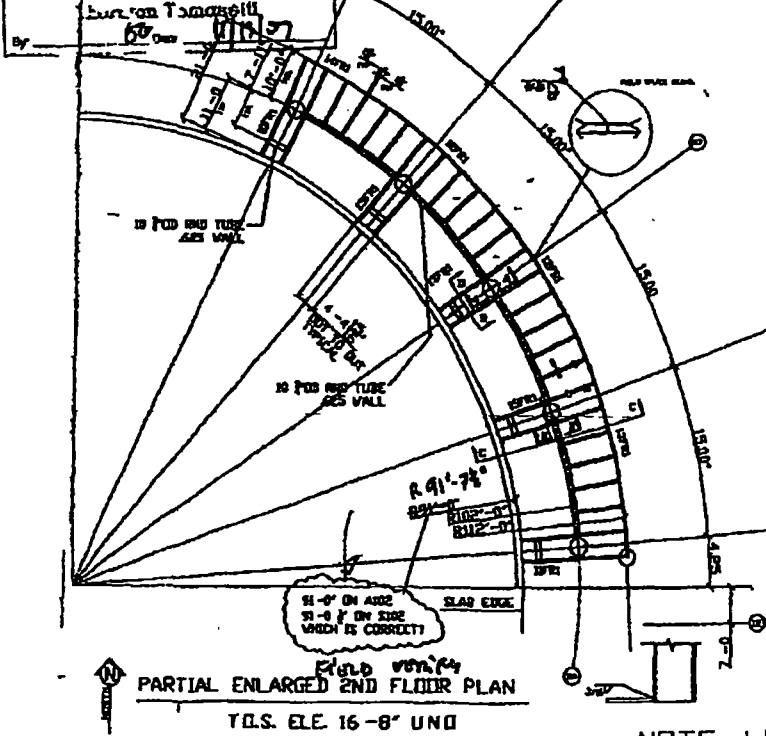

PARTIAL ENLARGED 2ND FLOOR PLAN  
T.O.S. ELE. 16'-8" UND

NOTE LEVEL 2 CANOPY IS SEQ 1

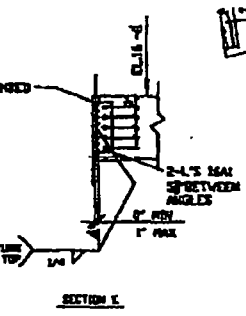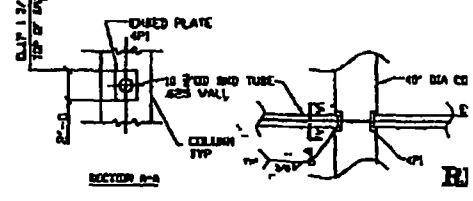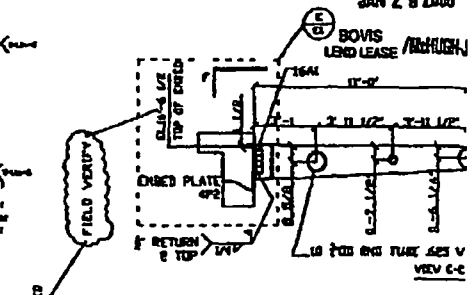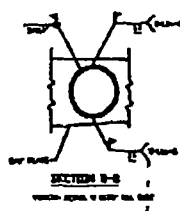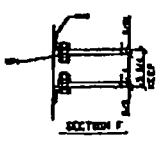

RECEIVED

JAN 29 2008

GENERAL NOTES	FDR APPROVA
SCALE	1/8" = 1'-0"
DRWG. NO.	2007-0212
DATE	NOV 02 2007
PROJECT	THE CA...
LOCATION	35 EAS...
DESCRIPTION	CANOPY
DATE	NOV 02 2007
BY	TH...



REVIEWED BY BOVIS/McHUGH - JV  
NOV 02 2007  
REG NO: 05120-0212  
PACK NO: 001-05200-0