



City of Chicago



Or2017-133

Office of the City Clerk

Document Tracking Sheet

Meeting Date:	3/29/2017
Sponsor(s):	Napolitano (41)
Type:	Order
Title:	Issuance of permits for sign(s)/signboard(s) at 11601 W Touhy Ave - Sign 6
Committee(s) Assignment:	Committee on Zoning, Landmarks and Building Standards

Committee on Zoning, Landmarks and Building Standards

(signs)

ORDERED, That the Commissioner of Buildings is hereby directed to issue 1 sign permit to:


Grate Signs
4044 W McDonough
Joliet, IL 60431

For the erection of one (1) awning sign over 24 feet in height and/or over 100 square feet (in area of one face) at:

11601 W Touhy
Chicago, IL 60666

#1	Dimensions: length	<u>26 feet</u>	height	<u>17 feet 8 inches</u>
	Height above grade/roof to top of sign			<u>38 feet</u>
	Total Square Foot Area			<u>459 square feet</u>
	Elevation			<u>East</u>

Such sign shall comply with all applicable provisions of TITLE 17 of the Chicago Zoning Ordinance and all other applicable provisions of the Municipal Code of the City of Chicago governing the construction and maintenance of outdoor signs, signboards and structures.


Anthony V Napolitano
Alderman, 41st Ward

PARACHIN design studios, llc.
 1410 West Adams Street, Suite 401
 Chicago, Illinois 60607
 Tel: 312-429-2560 Fax: 312-429-2285
 314.541.5635
 TomLee@PCLCC.com tomlee@pcsl.com





CDA Project No:
 TH131113-00

Clear Channel Airports
 CHICAGO, IL 60666
O'HARE INTERNATIONAL AIRPORT
 11601 WEST TOWER AVE
CCA - T3D PHASE I

PROJECT	CDA 100%	9/7/14
REVISION	11/20/15	
CDA 60%	7/20/15	
AS-BUILT	01/04/16	
Description:	Date:	

Sheet No:
C-3
 T1-U-TD

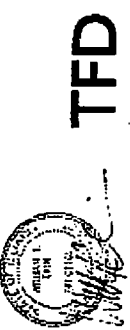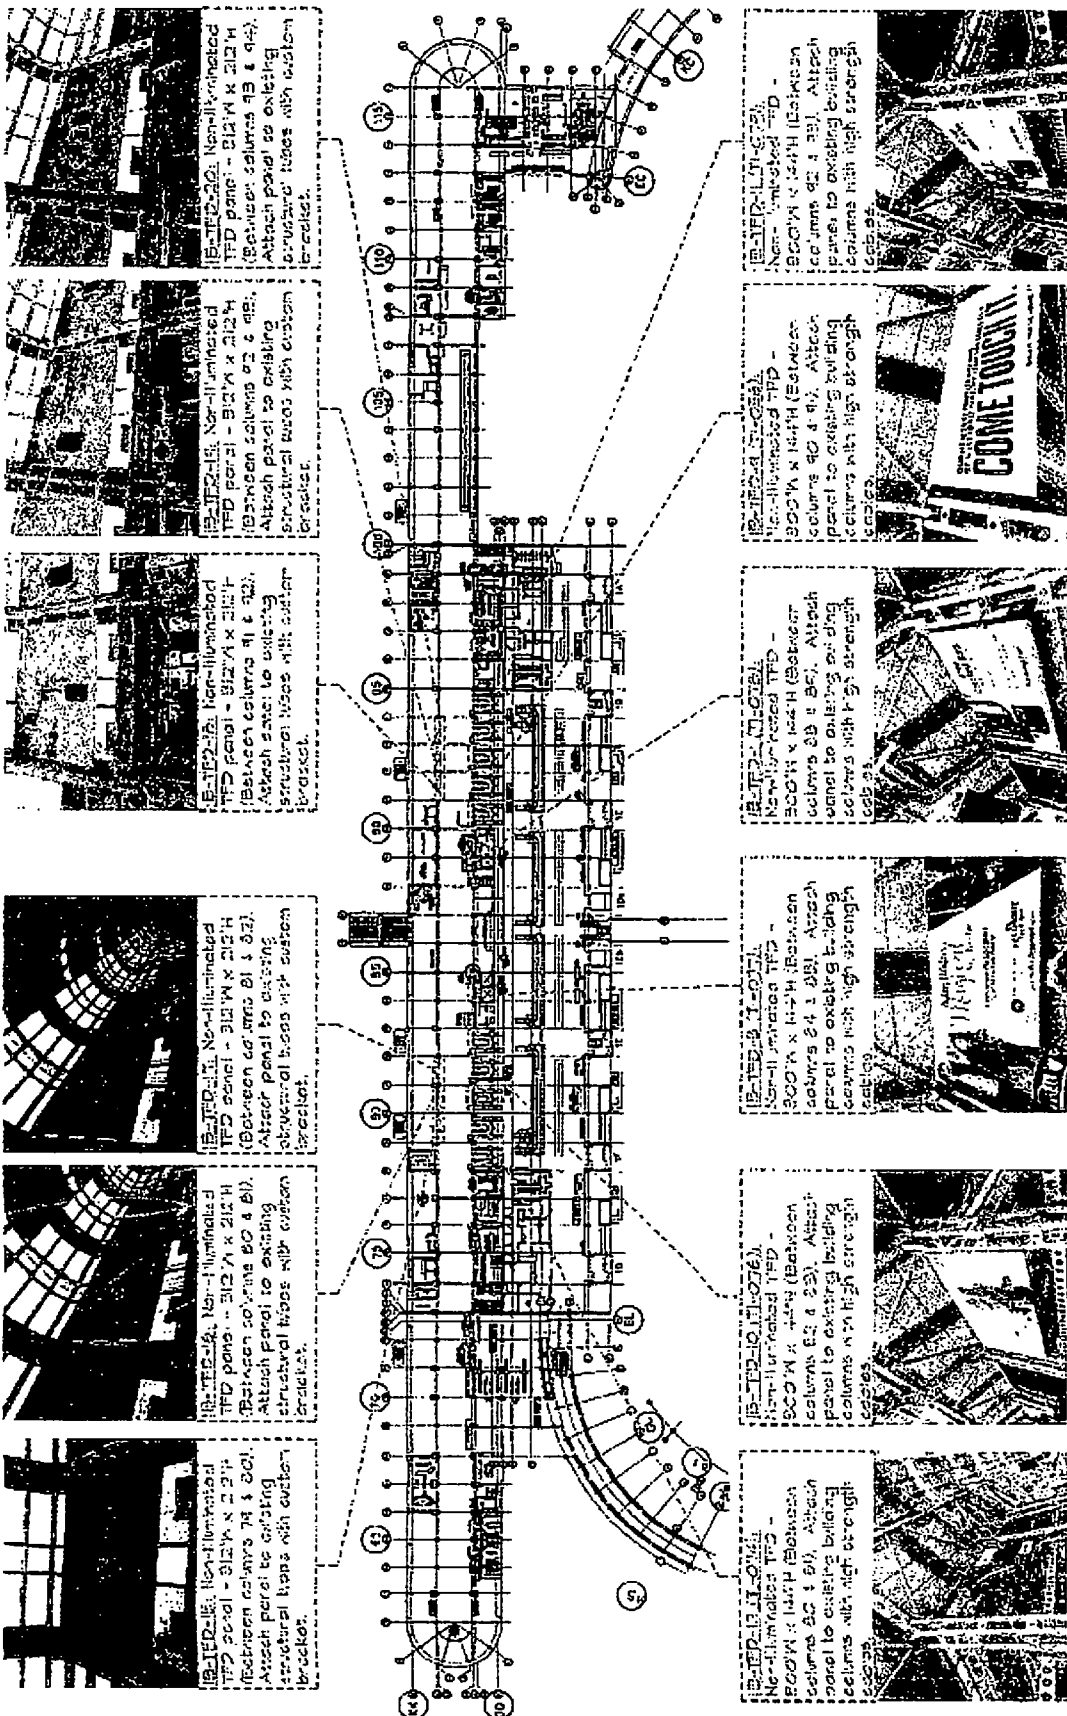

LOCATION PLAN - TERMINAL | CONCOURSE B - Upper Level

NTS



TFD