



City of Chicago



Or2017-137

Office of the City Clerk

Document Tracking Sheet

Meeting Date:	3/29/2017
Sponsor(s):	Napolitano (41)
Type:	Order
Title:	Issuance of permits for sign(s)/signboard(s) at 11601 W Touhy Ave - Sign 10
Committee(s) Assignment:	Committee on Zoning, Landmarks and Building Standards

Committee on Zoning, Landmarks and Building Standards

(signs)

ORDERED, That the Commissioner of Buildings is hereby directed to issue 1 sign permit to:


Grate Signs
4044 W McDonough
Joliet, IL 60431


For the erection of one (1) awning sign over 24 feet in height and/or over 100 square feet (in area of one face) at:

11601 W Touhy
Chicago, IL 60666

#1	Dimensions: length <u>25 feet</u>	height <u>12 feet</u>
	Height above grade/roof to top of sign	<u>32 feet</u>
	Total Square Foot Area	<u>300 square feet</u>
	Elevation	<u>West</u>

Such sign shall comply with all applicable provisions of TITLE 17 of the Chicago Zoning Ordinance and all other applicable provisions of the Municipal Code of the City of Chicago governing the construction and maintenance of outdoor signs, signboards and structures.

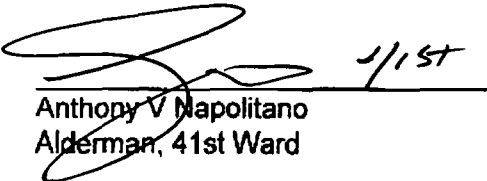
Anthony V Napolitano
Alderman, 41st Ward

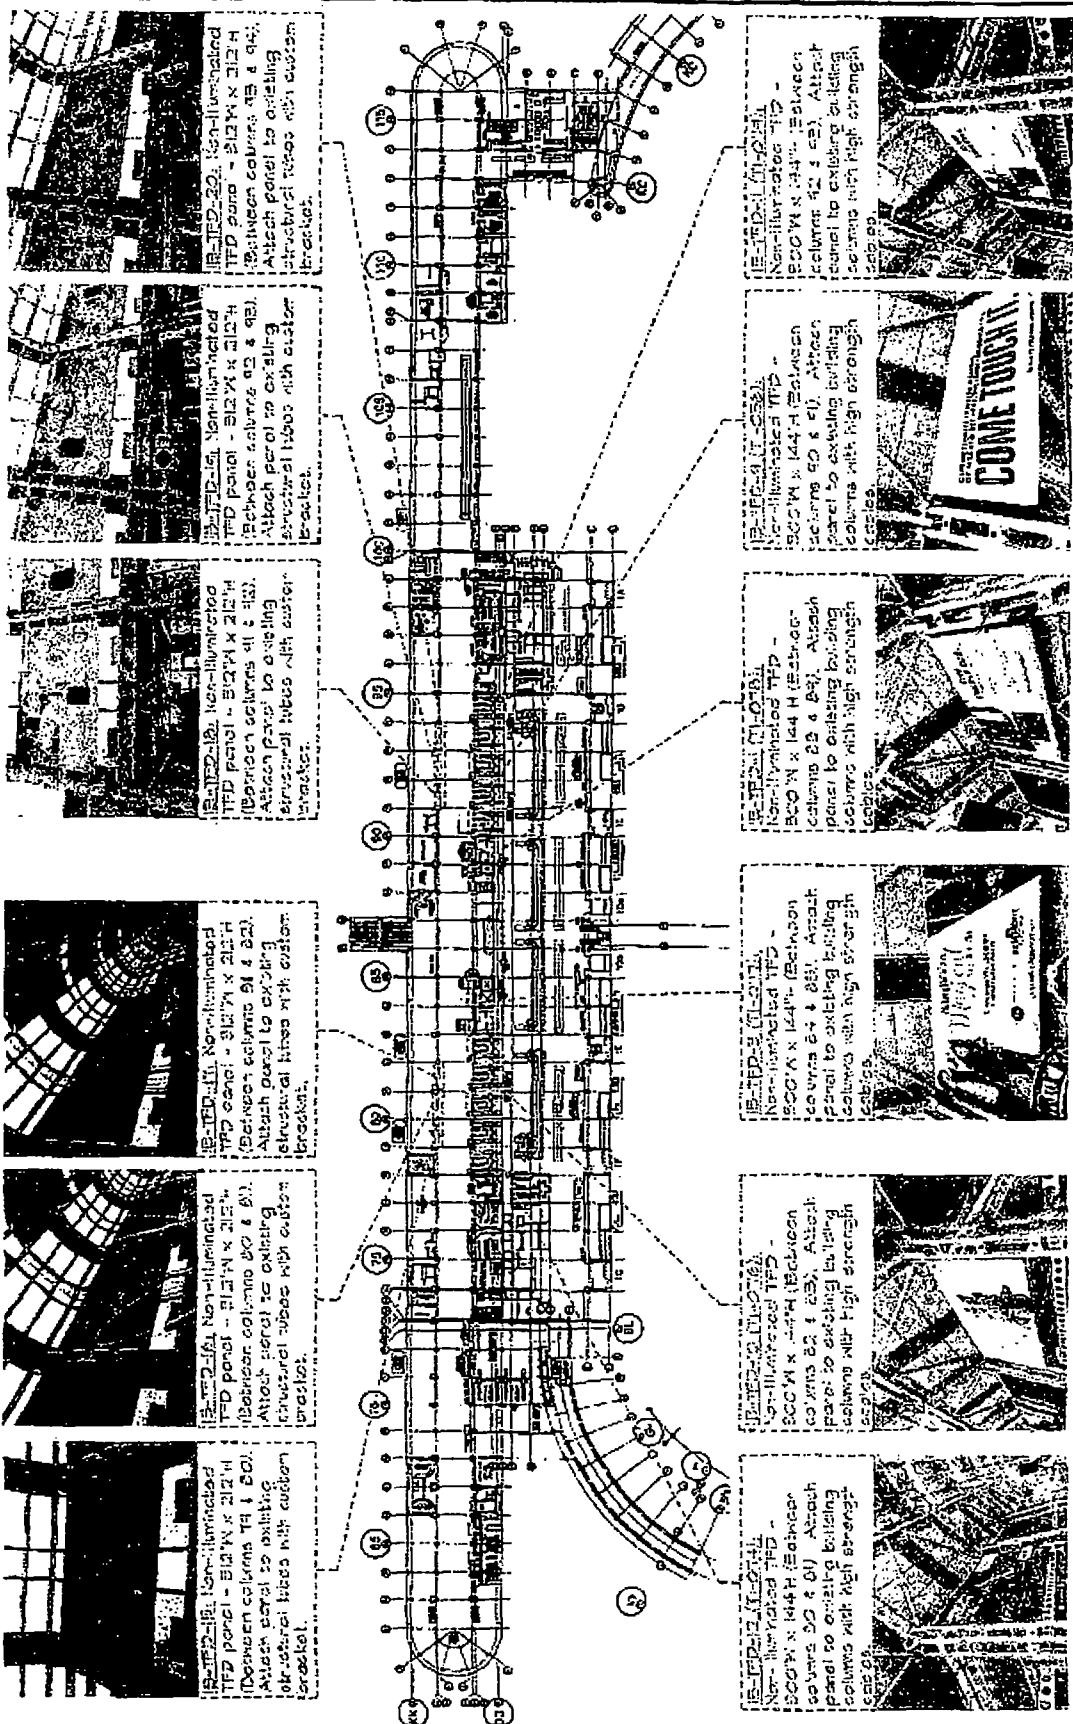

IR-TFD-18: Non-illuminated TFD panel - 512'4" x 212'4" (Between columns 01 & 02). Attach panel to existing structural tubes with custom brackets.

IR-TFD-19: Non-illuminated TFD panel - 512'4" x 212'4" (Between columns 02 & 03). Attach panel to existing structural tubes with custom brackets.

IR-TFD-20: Non-illuminated TFD panel - 512'4" x 212'4" (Between columns 03 & 04). Attach panel to existing structural tubes with custom brackets.

IR-TFD-21: Non-illuminated TFD panel - 512'4" x 212'4" (Between columns 04 & 05). Attach panel to existing structural tubes with custom brackets.

IR-TFD-22: Non-illuminated TFD panel - 512'4" x 212'4" (Between columns 05 & 06). Attach panel to existing structural tubes with custom brackets.

IR-TFD-23: Non-illuminated TFD panel - 512'4" x 212'4" (Between columns 06 & 07). Attach panel to existing structural tubes with custom brackets.

IR-TFD-24: Non-illuminated TFD - 500'4" x 144'4" (Between columns 07 & 08). Attach panel to existing building columns with high strength cables.

IR-TFD-25: Non-illuminated TFD - 500'4" x 144'4" (Between columns 08 & 09). Attach panel to existing building columns with high strength cables.

IR-TFD-26: Non-illuminated TFD - 500'4" x 144'4" (Between columns 09 & 10). Attach panel to existing building columns with high strength cables.

IR-TFD-27: Non-illuminated TFD - 500'4" x 144'4" (Between columns 10 & 11). Attach panel to existing building columns with high strength cables.

IR-TFD-28: Non-illuminated TFD - 500'4" x 144'4" (Between columns 11 & 12). Attach panel to existing building columns with high strength cables.

IR-TFD-29: Non-illuminated TFD - 500'4" x 144'4" (Between columns 12 & 13). Attach panel to existing building columns with high strength cables.

PARACHAIN design studios, ltd.
910 West Adams Street, Suite 403
Chicago, Illinois 60606
PH 312-829-2360 FAX 312-829-2366
314.541.5635
TomLee@TCLC.com or tomlee.com

CDA Project No: TH131113-00

PROJECT
CCA - TFD, PHASE I
O'HARE INTERNATIONAL AIRPORT
11801 WEST TOWNE AVE
CHICAGO, IL 60666

GDA 100%	9/7/14
REVISION	11/20/15
GDA 80%	1/30/16
AS-BUILT	2/10/16
Description:	Date:

Sheet No: C-3
TJ-UTD



LOCATION PLAN - TERMINAL I CONCOURSE B - Upper Level

TFD