



Office of the City Clerk



O2013-2135

Office of the City Clerk

City Council Document Tracking Sheet

Meeting Date:	3/13/2013
Sponsor(s):	Pawar, Ameya (47)
Type:	Ordinance
Title:	Awning(s) for Rockwell Partners
Committee(s) Assignment:	Committee on Transportation and Public Way

ORDINANCE
ROCKWELL PARTNERS
Acct. No. 378760 - 1
Permit No. 1104667

Be It Ordained by the City Council of the City of Chicago:

SECTION 1. Permission and authority are hereby given and granted to ROCKWELL PARTNERS, upon the terms and subject to the conditions of this ordinance to construct, install, maintain and use four (4) Awning(s) projecting over the public right-of-way adjacent to its premises known as 2607-2613 W. Lawrence Ave..

Said Awning(s) at W. Lawrence measure(s):

Two (2) at fifteen point nine two (15.92) feet in length, and two (2) feet in width for a total of sixty-three point six eight (63.68) square feet.

Two (2) at thirteen point two five (13.25) feet in length, and two (2) feet in width for a total of fifty-three (53) square feet.

The location of said privilege shall be as shown on prints kept on file with the Department of Business Affairs and Consumer Protection and the Office of the City Clerk.

Said privilege shall be constructed in accordance with plans and specifications approved by the Zoning Department - Signs.

This grant of privilege in the public way shall be subject to the provisions of Section 10-28-015 and all other required provisions of the Municipal Code of Chicago.


The grantee shall pay to the City of Chicago as compensation for the privilege #1104667 herein granted the sum of one hundred seventy-five (\$175.00) per annum in advance.

A 25% penalty will be added for payments received after due date.

The permit holder agrees to hold the City of Chicago harmless for any damage, relocation or replacement costs associated with damage, relocation or removal of private property caused by the City performing work in the public way.

Authority herein given and granted for a period of five (5) years from and after Date of Passage.

Alderman

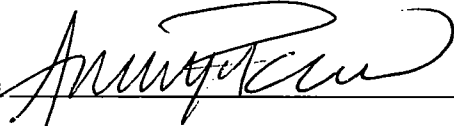

Ameya Pawar 47th Ward



03/13/2013

Alderman Ameya Pawar
Ward # **47**
City of Chicago
City Hall, Room **300**
121 North LaSalle Street
Chicago, Illinois 60602

Re: An ordinance to use and maintain a portion of the public right-of-way for **four (4) awning(s)** for **ROCKWELL PARTNERS**, adjacent to the premises known as **2607-2613 W. Lawrence Ave.**.

Dear Alderman **Ameya Pawar**:

The applicant referenced above has requested the use of the public right-of-way for a **awning(s)**. An ordinance has been prepared by the Department of Business Affairs and Consumer Protection – Business Assistance Center - Public Way Use Unit for presentation to the City Council. Because this request was made for properties located in your ward, as approved by you as per the attached, I respectfully request that you introduce the attached ordinance at the next City Council meeting.

If you have any questions regarding this ordinance, please contact Anthony Bertuca at (312) 744-5506.


Department of Business Affairs and Consumer Protection

2607-13 W. Lawrence


*** SIGN OFF REQUIREMENT ***

PLACE A CHECK MARK IN EACH BOX TO VERIFY THAT THE SPECIFICATION IS CORRECT
 ALL BOXES MUST BE CHECKED BEFORE THIS JOB IS CONSIDERED APPROVED FOR PRODUCTION
 ALL PAGES MUST BE SIGNED BEFORE THIS JOB IS CONSIDERED APPROVED FOR PRODUCTION

- FIVE AWNINGS COMPLETE, READY TO INSTALL
- BUILT IN ONE SECTION EACH
- 1X1 MILL FINISHED ALUMINUM TUBE FRAME
- SUNBRELLA 6026 (NAVY) FABRIC
- CP24 (NAVY) PVC TRIM
- HEAT TRANSFERRED WHITE VINYL COPY
- NO EGGCRATE
- NO NO LIGHTS
- 30 Z - CLIPS
- 18 S - CLIPS

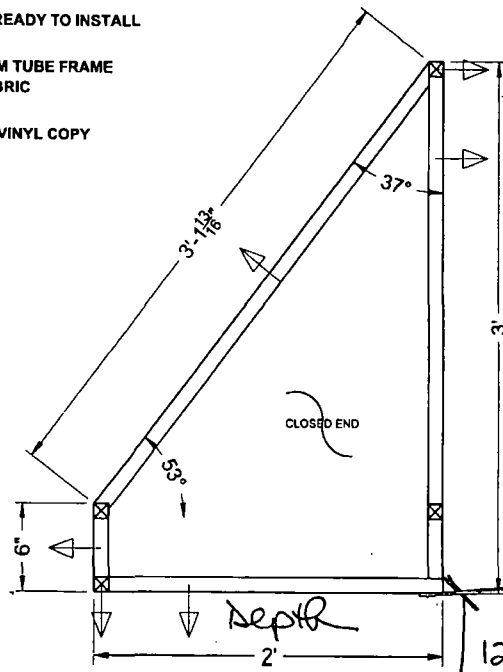

AWNINGS A,B,C,D
EXTERIOR TRUSS

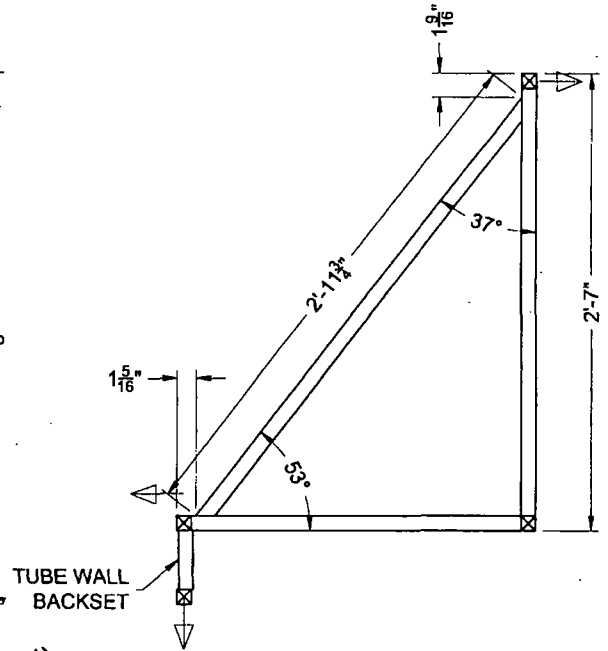

AWNINGS A,B,C,D
INTERIOR TRUSS

H.M. WITT & CO.
Signs
 THE SIGNAGE SPECIALISTS


3313 West Newport Ave. Chicago, IL 60618
 office: 1 773 250 5000 fax 1 773 250 5100
 toll free: 1 888 427 0703 web 1 www.hmwillt.com

		REVISIONS	CLIENT
APPROVED AS IS	<input type="radio"/>		Rockwell Partners / 2607-13 W. Lawrence
APPROVED W/CHANGES	<input type="radio"/>		DATE 02-08-13
REVISE AND RESUBMIT	<input type="radio"/>		JOB # Awnings
APPROVAL		DRAWN BY bs
DATE		SCALE No Scale


THIS IS AN ORIGINAL DRAWING BY H.M. WITT & CO. SIGNS AND IS NOT TO BE REPRODUCED WITHOUT PERMISSION OF H.M. WITT & CO. SIGNS.

2607-13 W. Lawrence

QTY - 1
AWNING A
GRAPHICS LAYOUT
FACE VIEW

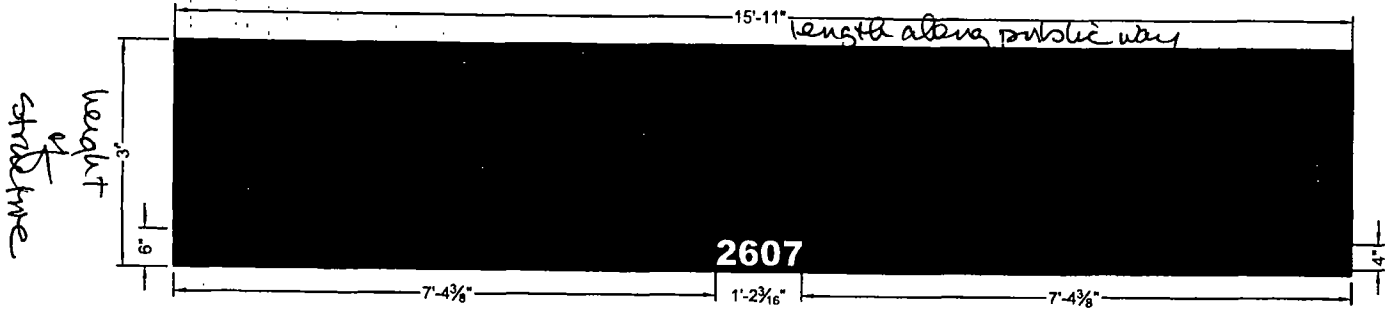

QTY - 1
AWNING B
GRAPHICS LAYOUT
FACE VIEW

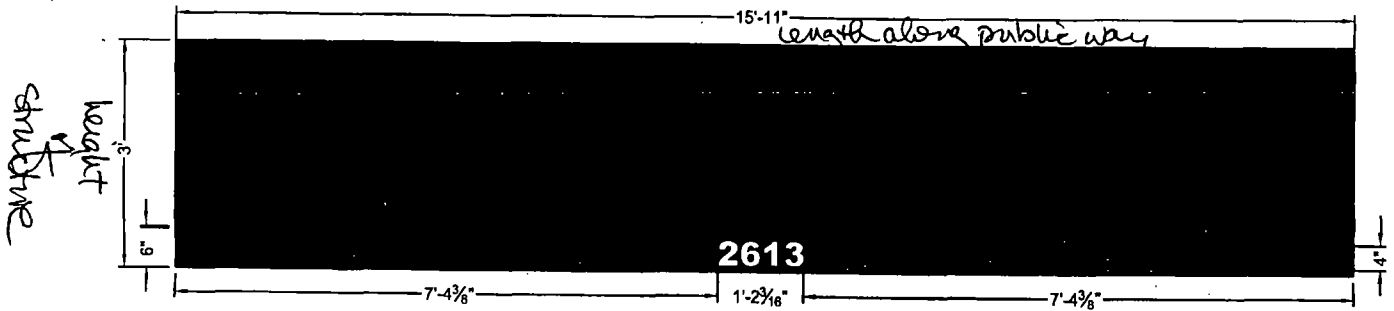

<p>3313 West Newport Ave. Chicago, IL 60618 office 773 250 5000 fax 773 250 5100 toll free 888 427 0703 web www.hmwitt.com</p>	APPROVED AS IS <input type="radio"/>	REVISIONS	CLIENT	Rockwell Partners / 2607-13 W. Lawrence
	APPROVED W/CHANGES <input type="radio"/>	DATE	02-08-13
	REVISE AND RESUBMIT <input type="radio"/>	JOB #	Awnings
	APPROVAL	DRAWN BY	bs
DATE	SCALE	No Scale	
THIS IS AN ORIGINAL DRAWING BY H.M. WITT & CO. SIGNS AND IS NOT TO BE REPRODUCED WITHOUT PERMISSION OF H.M. WITT & CO. SIGNS.				