



Office of the Chicago City
Clerk



O2012-546

Office of the City Clerk

City Council Document Tracking Sheet

Meeting Date:	1/18/2012
Sponsor(s):	Smith, Michele (43)
Type:	Ordinance
Title:	Grant(s) of privilege in public way for David Grossman
Committee(s) Assignment:	Committee on Transportation and Public Way

ORDINANCE
DAVID GROSSMAN
Acct. No. 366704 - 1
Permit No. 1098262

Be It Ordained by the City Council of the City of Chicago:

SECTION 1. Permission and authority are hereby given and granted to DAVID GROSSMAN, upon the terms and subject to the conditions of this ordinance to construct, install, maintain and use two (2) Ice Melt System(s) under the public right-of-way adjacent to its premises known as 1840 N. Orchard St..

Said Ice Melt System(s) at N. Orchard measure(s):

One (1) at seven point zero eight (7.08) feet in length, and fifty-two point six six (52.66) feet in width for a total of three hundred seventy-two point eight three (372.83) square feet

One (1) at seven point nine two (7.92) feet in length, and eighteen (18) feet in width for a total of one hundred forty-two point five six (142.56) square feet.

The location of said privilege shall be as shown on prints kept on file with the Department of Business Affairs and Consumer Protection and the Office of the City Clerk.

Said privilege shall be constructed in accordance with plans and specifications approved by the Department of Planning and Development and Department of Transportation (Office of Underground Coordination).

This grant of privilege in the public way shall be subject to the provisions of Section 10-28-015 and all other required provisions of the Municipal Code of Chicago.

The grantee shall pay to the City of Chicago as compensation for the privilege #1098262 herein granted the sum of four hundred thirty-nine (\$439.00) per annum in advance.

A 25% penalty will be added for payments received after due date.


The permit holder agrees to hold the City of Chicago harmless for any damage, relocation or replacement costs associated with damage, relocation or removal of private property caused by the City performing work in the public way.

Authority herein given and granted for a period of five (5) years from and after Date of Passage.

Alderman



Michele Smith 43rd Ward

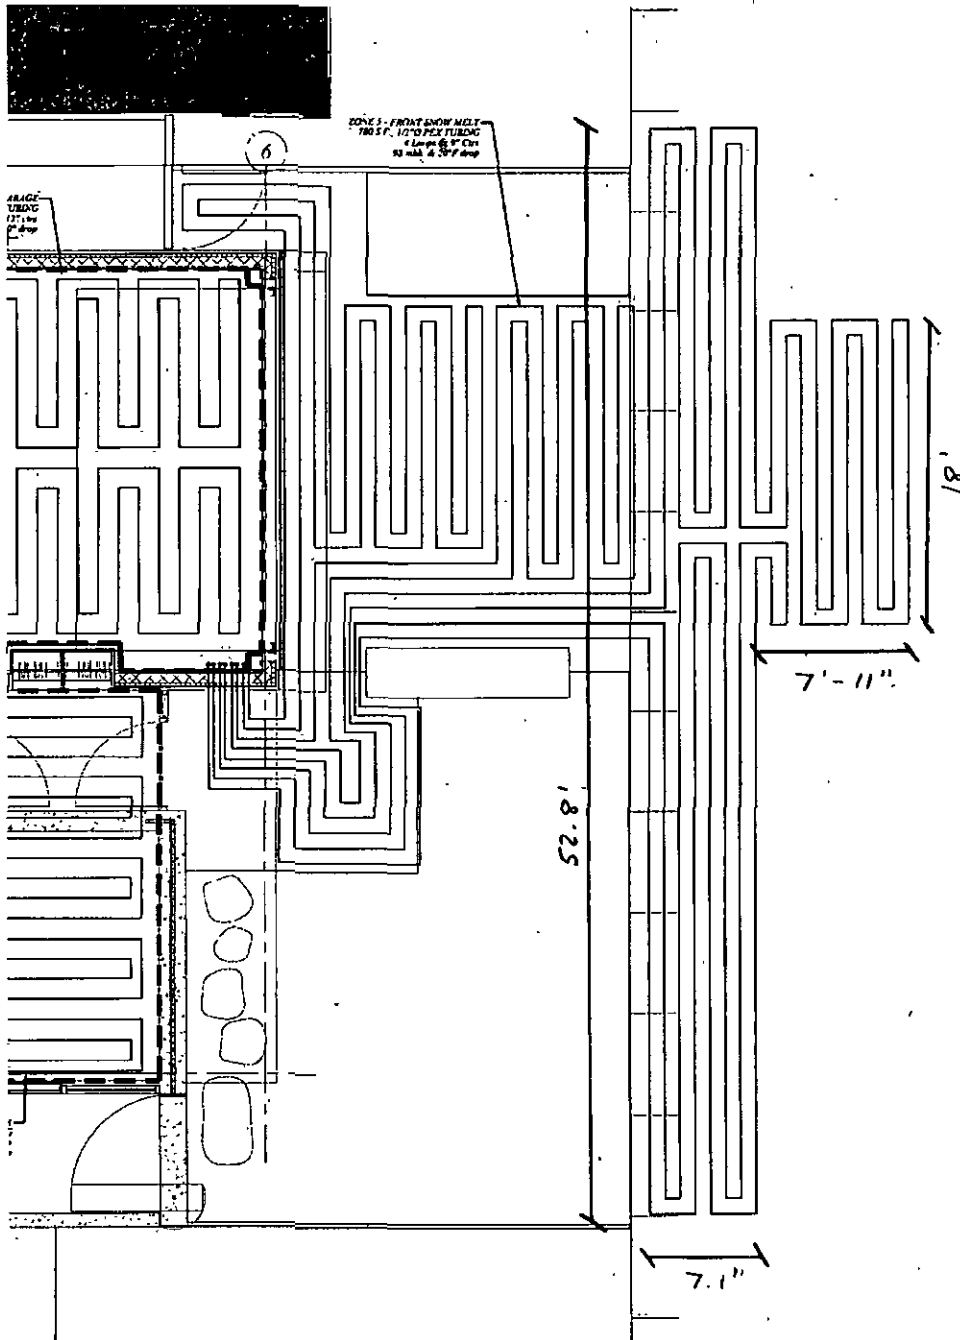

Prepared For



AT MECHANICAL
 MECHANICAL & DESIGN
 1111 W. PULASKI AVENUE
 CHICAGO, ILL. 60642
 PH: (312) 415-7945
 FAX: (312) 415-7946

PROFESSIONAL REGISTRATION

ATMC PROJECT NUMBER
11-003

PLOT DATE

March 10, 2011

FILE LOCATION

11-003-1340 N Orchard (2011-06-14)M.dwg

DRAWN BY

BLW

CHECKED BY

AT

-Errors may occur in the transmission of electronic files.
 AT Mechanical is not responsible for any errors, damages or expenses arising out of the unauthorized use of the information contained in electronic files.
 -Electronic files may not accurately reflect the final as-built conditions. It is the responsibility of the user to verify all layout, dimensions and other related information.
 -This document may not be used or copied without prior written consent.
 -All reports, plans, specifications, computer files, field data, notes and other documents and instruments prepared by the design professional or instruments of service shall remain the property of the design professional. The design professional shall retain all common law, statutory and other reserved rights, including the copyright therein.

NO	REVISION LOG	DATE & INITIALS
1	ISSUED FOR PERMIT	BLW 11/03/10
2	ISSUED FOR CONSTRUCTION	BLW 12/07/10
3	CHANGES FOR ARCHITECTURAL SETS	BLW 01/06/11
4	REVISIONS FOR FIELD CONDITIONS	BLW 03/06/11
5	REVISIONS OF THE FLOOR PLAN SET	BLW 06/24/11

PROJECT

**Residence @
 1840 North Orchard**

LOCATION

1840 North Orchard
 Chicago, Illinois 60614

SHEET TITLE

**RADIANT HEAT TUBING
 PLAN**

SHEET NUMBER

M-4