



# City of Chicago



O2019-8888

## Office of the City Clerk Document Tracking Sheet

<b>Meeting Date:</b>	11/13/2019
<b>Sponsor(s):</b>	Napolitano (41)
<b>Type:</b>	Ordinance
<b>Title:</b>	Grant(s) of privilege in public way for Ombudsman Educational Services
<b>Committee(s) Assignment:</b>	Committee on Transportation and Public Way

ORDINANCE  
OMBUDSMAN EDUCATIONAL SVCS.  
Acct. No. 88802 - 2  
Permit No. 1142777

*Be It Ordained by the City Council of the City of Chicago:*

SECTION 1. Permission and authority are hereby given and granted to OMBUDSMAN EDUCATIONAL SVCS., upon the terms and subject to the conditions of this ordinance to maintain and use two (2) sign(s) projecting over the public right-of-way attached to its premises known as 7500 N. Harlem Ave..

Said sign structure(s) measures as follows; along N. Harlem:

One (1) at sixteen point zero eight (16.08) feet in length, two point six seven (2.67) feet in height and twelve (12) feet above grade level.

Said sign structure(s) measures as follows; along W. Birchwood:

One (1) at sixteen point zero eight (16.08) feet in length, two point six seven (2.67) feet in height and eleven (11) feet above grade level.

The location of said privilege shall be as shown on prints kept on file with the Department of Business Affairs and Consumer Protection and the Office of the City Clerk.

Said privilege shall be constructed in accordance with plans and specifications approved by the Department of Transportation (Division of Project Development) and Zoning Department - Signs.


This grant of privilege in the public way shall be subject to the provisions of Section 10-28-015 and all other required provisions of the Municipal Code of Chicago.


The grantee shall pay to the City of Chicago as compensation for the privilege #1142777 herein granted the sum of six hundred (\$600.00) per annum in advance.

A 25% penalty will be added for payments received after due date.

The permit holder agrees to hold the City of Chicago harmless for any damage, relocation or replacement costs associated with damage, relocation or removal of private property caused by the City performing work in the public way.

Authority herein given and granted for a period of five (5) years from and after 11/05/2019.

Alderman \_\_\_\_\_   
Anthony V. Napolitano 41<sup>st</sup> Ward

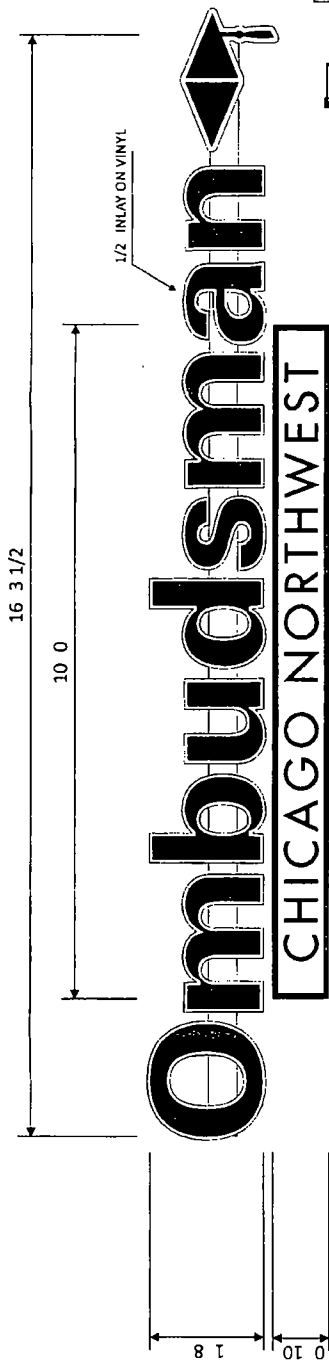

(2) COMPLETE SETS OF LED ILLUMINATED CHANNEL LETTERS WITH A 20" HEIGHT RACEWAY MOUNTED WHITE ACRYLIC FACES WITH PERFORATED VINYL OVERLAY FACES ARE TO BE TRIMCAPPED FOR A SHOEBOX FIT. CABINET DEPTH TO BE 5" HIGH AND 3 1/2" DEEP. UL LISTED WITH SERVICE SWITCH INSTALLED.

(2) COMPLETE LED ILLUMINATED CHANNEL LETTER MODULES TO BE WALL MOUNTED. CABINET DEPTH TO BE 8 1/5". WHITE ACRYLIC FACE WITH FIRST SURFACE VINYL DECORATION. MODULE IS TO HAVE A 1" RETAINER. UL LISTED WITH SERVICE SWITCH INSTALLED.

**COLORS**  
 CHANNEL FACES - PERFORATED BLACK  
 MODULE COPY - BLACK  
 CABINETS/TRIM - BLACK  
 BACKGROUND/INLAY - WHITE  
 LOGO - BLACK 3630 83 REGAL RED

**OMBUDSMAN**  
 7500 N HARLEM  
 CHICAGO, IL  
 ORDER #

**TYPICAL RACEWAY MOUNTED LED CHANNEL LETTERS**  
 U L 2161 LISTED AND 1999 N E C COMPLIANT  
 NOT TO SCALE

ACCEPTED BY \_\_\_\_\_ DATE \_\_\_\_\_

ALL INFORMATION CONTAINED ON THIS DRAWING IS CONFIDENTIAL AND PROPRIETARY. IT IS THE SOLE PROPERTY OF ADAMS SIGNS AND IS NOT TO BE REPRODUCED BY ANYONE WITHOUT WRITTEN CONSENT FROM ADAMS SIGNS. THIS SIGN SHALL REMAIN THE PROPERTY OF ADAMS SIGNS UNTIL FULLY PAID FOR. THE INTENT OF THIS DRAWING IS TO SHOW A CONCEPTUAL REPRESENTATION OF THE PROPOSED SIGNAGE. DUE TO VARIATIONS IN PRINTING DEVICES AND SUBSTRATES, THE FINISHED PRODUCT MAY DIFFER SLIGHTLY FROM DRAWING.	
<b>ADAMS ELECTRIC SIGNS</b> <b>CHICAGO, IL</b>	DARRYL MARTIN 7772 W CENTRAL AVE RIVER FOREST IL 60305 312 859 4096
AS BUILT	CABINET TRIM SIZE
SCALE 1/2" = 1' 0"	DATE 7 02 14 / 7 31 14
SALES DARRYL	ART NV
DWG # 0714003	CKD
FACE TRIM SIZE	



11/13/2019

Alderman **Anthony V. Napolitano**  
Ward # **41**  
City of Chicago  
City Hall, Room **200**  
121 North LaSalle Street  
Chicago, Illinois 60602

Re: An ordinance to use and maintain a portion of the public right-of-way for **two (2) sign(s)** for  
**OMBUDSMAN EDUCATIONAL SVCS.**, adjacent to the premises known as **7500 N. Harlem**  
**Ave.**

Dear Alderman **Anthony V. Napolitano**:

The applicant referenced above has requested the use of the public right-of-way for a **sign(s)**. An ordinance has been prepared by the Department of Business Affairs and Consumer Protection – Small Business Center - Public Way Use Unit for presentation to the City Council. Because this request was made for properties located in your ward, as approved by you as per the attached, I respectfully request that you introduce the attached ordinance at the next City Council meeting.

If you have any questions regarding this ordinance, please contact Anthony Bertuca at (312) 744-5506.

**Department of Business Affairs and Consumer Protection**