



# City of Chicago



O2016-1926

Office of the City Clerk

## Document Tracking Sheet

<b>Meeting Date:</b>	3/16/2016
<b>Sponsor(s):</b>	Hairston (5)
<b>Type:</b>	Ordinance
<b>Title:</b>	Grant(s) of privilege in public way for University of Chicago Hospital, The - earth retention system
<b>Committee(s) Assignment:</b>	Committee on Transportation and Public Way

ORDINANCE  
THE UNIVERSITY OF CHICAGO HOSPITAL  
Acct. No. 6533 - 10  
Permit No. 1121529

*Be It Ordained by the City Council of the City of Chicago:*

SECTION 1. Permission and authority are hereby given and granted to THE UNIVERSITY OF CHICAGO HOSPITAL, upon the terms and subject to the conditions of this ordinance to maintain and use, as now constructed, one (1) Earth Retention System(s) under the public right-of-way adjacent to its premises known as 5730 S. Drexel Ave.. Existing earth retention system measure thirty-four (34) feet in length and contain a total of twenty-five (25) tie-backs at a minimum of six (6) feet below grade level.

The location of said privilege shall be as shown on prints kept on file with the Department of Business Affairs and Consumer Protection and the Office of the City Clerk.

Said privilege shall be constructed in accordance with plans and specifications approved by the Department of Transportation (Office of Underground Coordination).

This grant of privilege in the public way shall be subject to the provisions of Section 10-28-015 and all other required provisions of the Municipal Code of Chicago.


The grantee shall pay to the City of Chicago as compensation for the privilege #1121529 herein granted the sum of four hundred (\$400.00) per annum in advance.

A 25% penalty will be added for payments received after due date.


The permit holder agrees to hold the City of Chicago harmless for any damage, relocation or replacement costs associated with damage, relocation or removal of private property caused by the City performing work in the public way.

Authority herein given and granted for a period of five (5) years from and after 02/09/2015.

Alderman

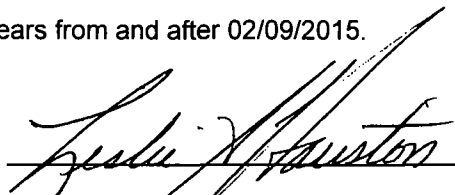

Leslie Hairston 5th Ward

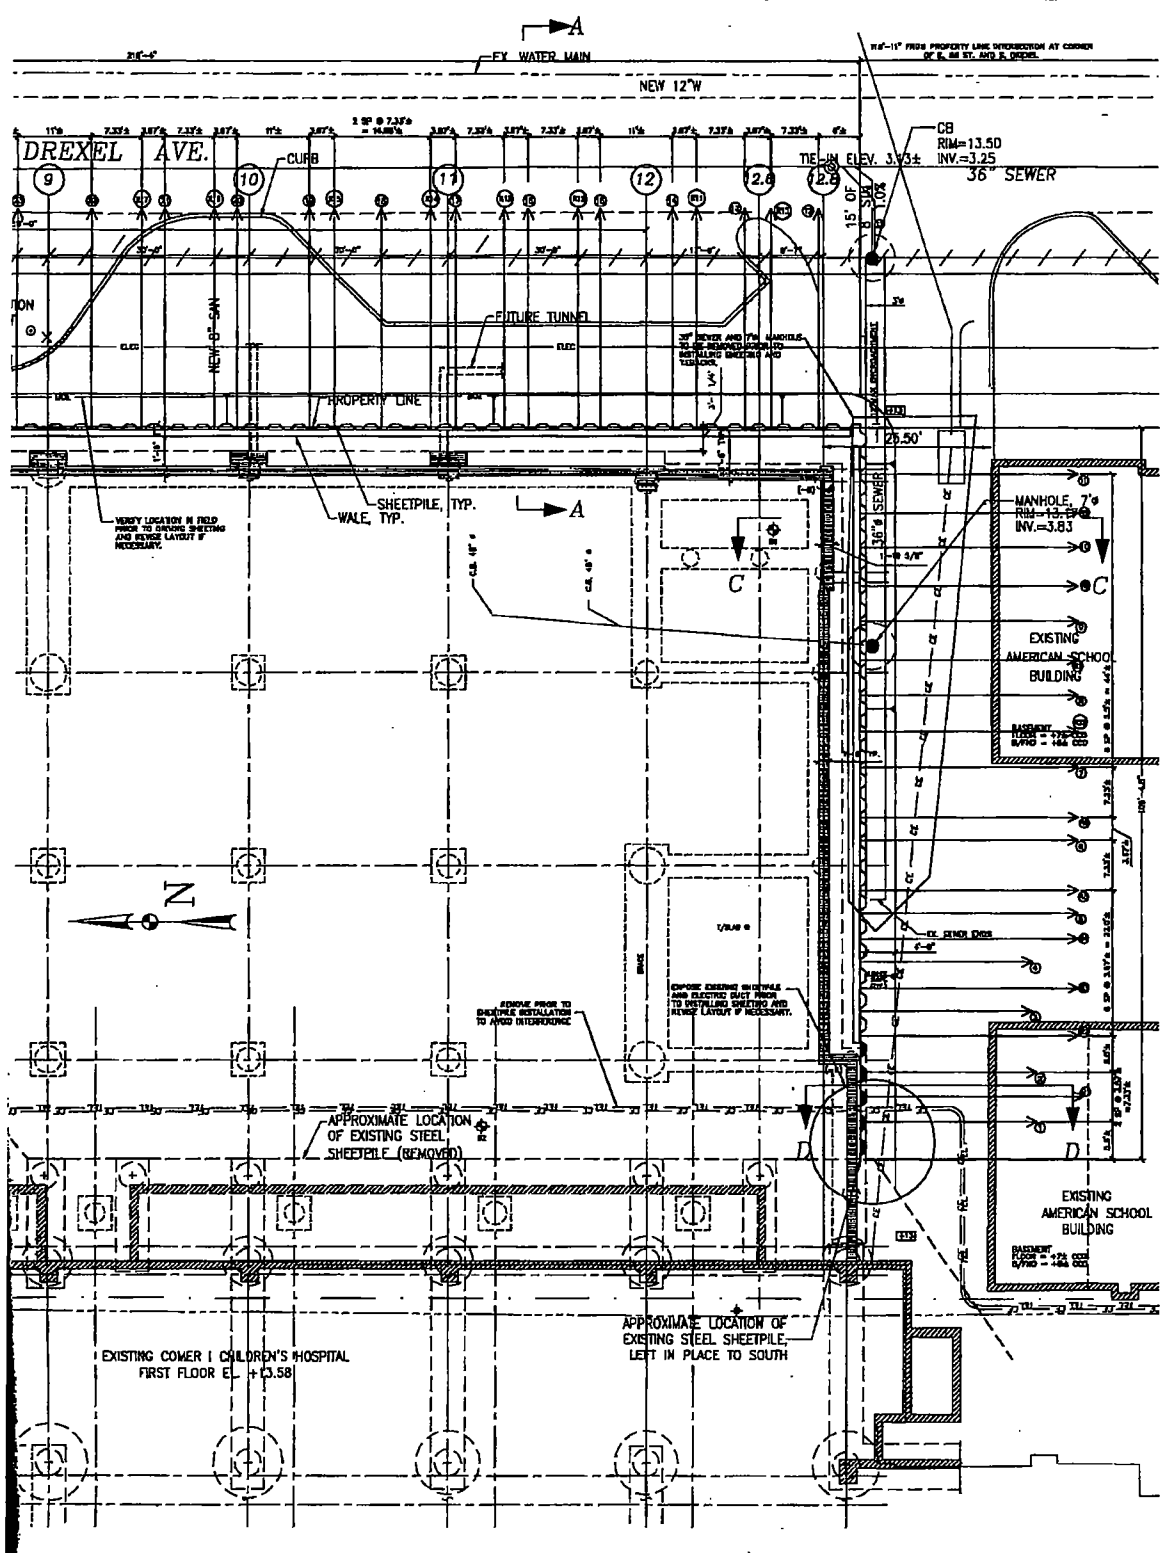

The earth retention system shown on these plans has been designed by SCHNABEL FOUNDATION COMPANY for construction by SCHNABEL FOUNDATION COMPANY only. These plans shall be used for no other purpose unless specifically authorized in writing by SCHNABEL FOUNDATION COMPANY.

REVISIONS	
1	12/13/04 ISSUE FOR PERMIT
2	12/29/04 FOR UTILITY REVIEW (DUC SUBMITTAL)
3	3/1/05 ISSUE FOR CONSTRUCTION
4	1/10/06 AS-BUILTS

TEMPORARY EARTH RETENTION SYSTEM	
UNIVERSITY OF CHICAGO COMER II CHILDREN'S HOSPITAL	
CHICAGO, ILLINOIS	
GCH Landscape Company, Inc. Architect: Belski Group, Inc.	
<b>Schnabel</b> Engineers and Contractors	
FOUNDATION COMPANY CARY, ILLINOIS	
ATLANTA • BOSTON • DENVER • HOUSTON PHILADELPHIA • SAN FRANCISCO • WASHINGTON, D.C.	
08-3673	Date: 12/13/04
Drawn By: JV	Dwg. No.: ERS 1 of 3



**03/16/2016**

**Alderman Leslie Hairston**  
**Ward # 05**  
City of Chicago  
City Hall, Room 300  
121 North LaSalle Street  
Chicago, Illinois 60602

Re: An ordinance to use and maintain a portion of the public right-of-way for **one (1) earth retention system(s)** for **THE UNIVERSITY OF CHICAGO HOSPITAL**, adjacent to the premises known as **5730 S. Drexel Ave.**

Dear Alderman **Leslie Hairston**:

The applicant referenced above has requested the use of the public right-of-way for a **earth retention system(s)**. An ordinance has been prepared by the Department of Business Affairs and Consumer Protection – Small Business Center - Public Way Use Unit for presentation to the City Council. Because this request was made for properties located in your ward, as approved by you as per the attached, I respectfully request that you introduce the attached ordinance at the next City Council meeting.

If you have any questions regarding this ordinance, please contact Anthony Bertuca at (312) 744-5506.

**Department of Business Affairs and Consumer Protection**