



# Office of the City Clerk



O2012-6035

Office of the City Clerk

## City Council Document Tracking Sheet

<b>Meeting Date:</b>	9/12/2012
<b>Sponsor(s):</b>	Smith, Michele (43)
<b>Type:</b>	Ordinance
<b>Title:</b>	Grant(s) of privilege in public way for Tracey Powell
<b>Committee(s) Assignment:</b>	Committee on Transportation and Public Way

ORDINANCE  
TRACEY POWELL  
Acct. No. 68648 - 1  
Permit No. 1102578

*Be It Ordained by the City Council of the City of Chicago:*

SECTION 1. Permission and authority are hereby given and granted to TRACEY POWELL, upon the terms and subject to the conditions of this ordinance to maintain and use, as now constructed, one (1) Stairway projecting over the public right-of-way adjacent to its premises known as 1214 N. Astor St.. Existing steel stairway extends five (5) feet over and above an east/west public alley. Steel stairway measure twenty-nine (29) feet in length and five (5) feet in width emerging from the aforementioned premises at the third (3<sup>rd</sup>) floor level, twenty-two (22) feet above alley grade, thence ascending to the fourth (4<sup>th</sup>) floor and thence to the roof. The purpose of this stairway is to provide access to the roof sundeck.

The location of said privilege shall be as shown on prints kept on file with the Department of Business Affairs and Consumer Protection and the Office of the City Clerk.

Said privilege shall be constructed in accordance with plans and specifications approved by the Department of Transportation (Division of Project Development).

This grant of privilege in the public way shall be subject to the provisions of Section 10-28-015 and all other required provisions of the Municipal Code of Chicago.

The grantee shall pay to the City of Chicago as compensation for the privilege #1102578 herein granted the sum of four hundred (\$400.00) per annum in advance.

A 25% penalty will be added for payments received after due date.



The permit holder agrees to hold the City of Chicago harmless for any damage, relocation or replacement costs associated with damage, relocation or removal of private property caused by the City performing work in the public way.

Authority herein given and granted for a period of five (5) years from and after 09/12/2005.

Alderman



Michele Smith 43rd Ward

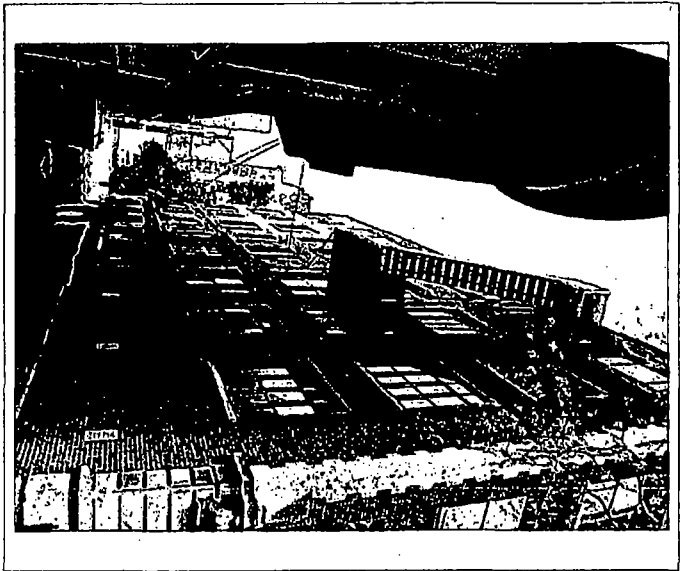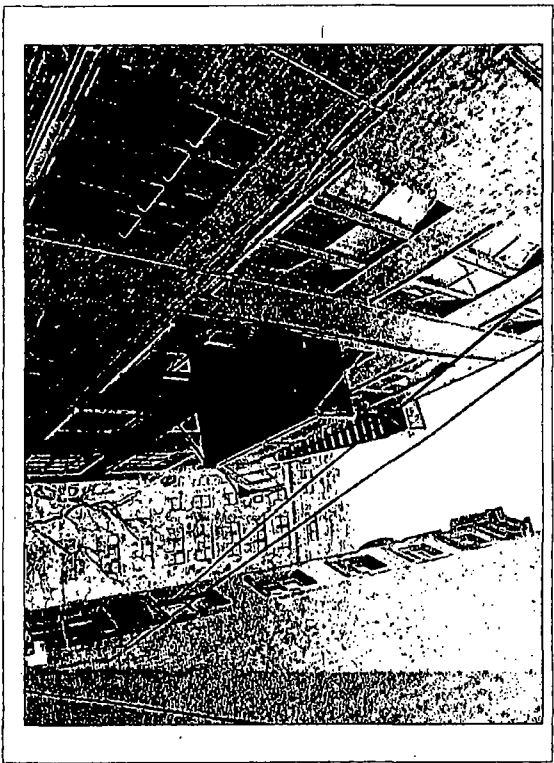

4/30/2012  
 DESIGN  
 SYNERGIES,  
 LTD.  
 1110 N. LAUREL  
 CHICAGO, IL 60610  
 TEL: 312.467.1118  
 WWW.SYNERGIESLTD.COM  
 CHICAGO, IL 60610  
 AS-BUILT  
 STAIRCASE  
 G3.0

1214 N ASTOR ST.  
 1214 N ASTOR ST.  
 CHICAGO, IL 60610
