



Office of the Chicago City  
Clerk



O2012-481

Office of the City Clerk

City Council Document Tracking Sheet

<b>Meeting Date:</b>	1/18/2012
<b>Sponsor(s):</b>	Osterman, Harry (48)
<b>Type:</b>	Ordinance
<b>Title:</b>	Grant(s) of privilege in public way for BMO Harris Bank
<b>Committee(s) Assignment:</b>	Committee on Transportation and Public Way

ORDINANCE  
BMO HARRIS BANK  
Acct. No. 367785 - 5  
Permit No. 1098707

*Be It Ordained by the City Council of the City of Chicago:*

SECTION 1. Permission and authority are hereby given and granted to BMO HARRIS BANK, upon the terms and subject to the conditions of this ordinance to maintain and use two (2) sign(s) projecting over the public right-of-way attached to its premises known as 5711 N. Clark St..

Said sign structure(s) measures as follows; along N. Clark:

One (1) at three (3) feet in length, three (3) feet in height and ten (10) feet above grade level.

One (1) at twenty point two five (20.25) feet in length, two point eight three (2.83) feet in height and ten (10) feet above grade level.

The location of said privilege shall be as shown on prints kept on file with the Department of Business Affairs and Consumer Protection and the Office of the City Clerk.

Said privilege shall be constructed in accordance with plans and specifications approved by the Department of Transportation (Division of Project Development) and Zoning Department - Signs.

This grant of privilege in the public way shall be subject to the provisions of Section 10-28-015 and all other required provisions of the Municipal Code of Chicago.


The grantee shall pay to the City of Chicago as compensation for the privilege #1098707 herein granted the sum of four hundred (\$400.00) per annum in advance.

A 25% penalty will be added for payments received after due date.


The permit holder agrees to hold the City of Chicago harmless for any damage, relocation or replacement costs associated with damage, relocation or removal of private property caused by the City performing work in the public way.

Authority herein given and granted for a period of five (5) years from and after Date of Passage.

Alderman


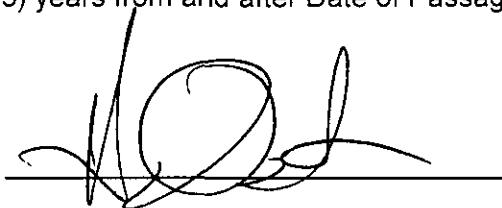
A handwritten signature in black ink, appearing to read 'Harry Osterman', written over a horizontal line.

Harry Osterman 48<sup>th</sup> Ward

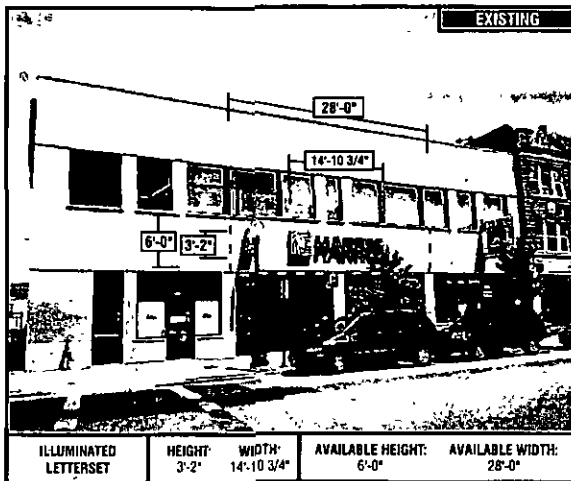

RESTORATION AREA  
see "NOTE" for details

**SIGN 1**

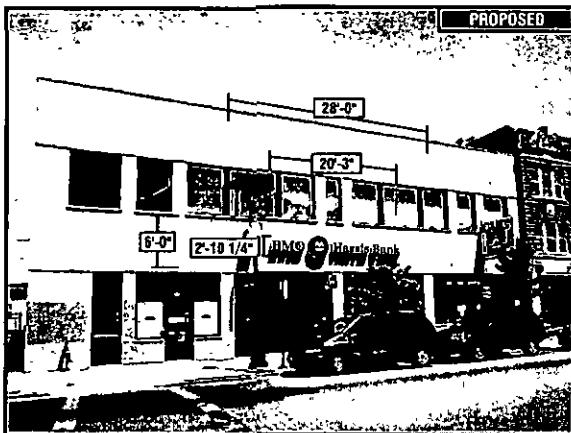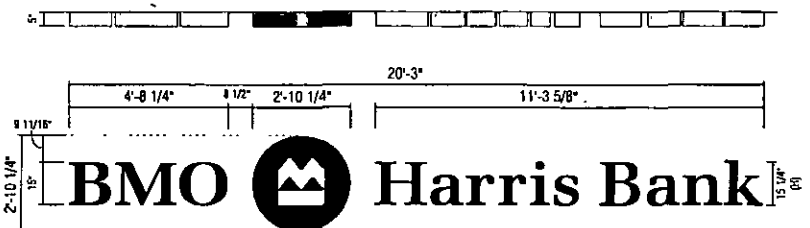

IL-15-BR (57.8 SQ. FT.)

Qty. 1

Scale 1/4"=1'-0"

NOTE: PATCH AND PAINT BREAK TO BREAK  
ELECTRICAL- USE EXISTING  
WALL COLOR- BEIGE  
WALL TYPE- EIFS

	<b>RECOMMENDATIONS</b>		PROJECT #	SUBMITTAL #	DATE	SCALE	
	ADDRESS: 5711 N. Clark CITY/STATE: Chicago IL ZIP: 60660		3683	<input type="checkbox"/> APPROVED <input type="checkbox"/> APPROVED AS NOTED <input type="checkbox"/> REVISED AND RESUBMIT	08/01/11 Rev 1: 00/00/00 Rev 2: 00/00/00 Rev 3: 00/00/00 Rev 4: 00/00/00 Rev 5: 00/00/00	As Noted DRAWN BY: AR PAGE # 7	
		LOCATION #	FILE PATH				
		4499	Active\BANKSV\Harris Bank_Project 3683_BMO\Locations\3683_4499_Chicago_IL.cdr				
<small>Drawings are the exclusive property of Icon Ready Solutions Inc. Any unauthorized use or duplication is not permitted.</small>							



01/18/2012

Alderman **Harry Osterman**  
Ward # **48**  
City of Chicago  
City Hall, Room 300  
121 North LaSalle Street  
Chicago, Illinois 60602

Re: An ordinance to use and maintain a portion of the public right-of-way for **two (2) sign(s)** for **BMO HARRIS BANK**, adjacent to the premises known as **5711 N. Clark St.**

Dear Alderman **Harry Osterman**:

The applicant referenced above has requested the use of the public right-of-way for a **sign(s)**. An ordinance has been prepared by the Department of Business Affairs and Consumer Protection – Business Assistance Center - Public Way Use Unit for presentation to the City Council. Because this request was made for properties located in your ward, as approved by you as per the attached, I respectfully request that you introduce the attached ordinance at the next City Council meeting.

If you have any questions regarding this ordinance, please contact Anthony Bertuca at (312) 744-5506.

**Department of Business Affairs and Consumer Protection**