



City of Chicago



O2021-3562

Office of the City Clerk

Document Tracking Sheet

Meeting Date:	9/9/2021
Sponsor(s):	Sigcho-Lopez (25)
Type:	Ordinance
Title:	Grant(s) of privilege in public way for T-Mobile
Committee(s) Assignment:	Committee on Transportation and Public Way

ORDINANCE

T-MOBILE

Acct. No.: 308614 - 1

Permit No: BACP1556353

Be It Ordained by the City Council of the City of Chicago:

SECTION 1. Permission and authority are hereby given and granted to T-MOBILE upon the terms and subject to the conditions of this ordinance to maintain and use two (2) Sign(s) projecting over the public right-of-way attached to its premises known as 606 W ROOSEVELT RD.

Said Sign structure(s) measures as follows along W. Roosevelt Road:

One (1) at seventeen point two (17.2) feet in length, three point five (3.5) feet in height and nine (9) feet above grade level.

Said Sign structure(s) measures as follows along :

One (1) at seventeen point two (17.2) feet in length, three point five (3.5) feet in height and nine (9) feet above grade level.

The location of said privilege shall be as shown on prints kept on file with the Department of Business Affairs and Consumer Protection and the Office of the City Clerk.

Said privilege shall be constructed in accordance with plans and specifications approved by the Zoning Department - Signs.

This grant of privilege in the public way shall be subject to the provisions of Section 10-28-015 and all other required provisions of the Municipal Code of Chicago.

The grantee shall pay to the City of Chicago as compensation for the privilege #BACP 1556353 herein granted the sum of six hundred (\$600.00) per annum in advance.

A 25% penalty will be added for payments received after due date.

The permit holder agrees to hold the City of Chicago harmless for any damage, relocation or replacement costs associated with damage, relocation or removal of private property caused by the City performing work in the public way.

Authority herein given and granted for a period of five (5) years from and after 02/09/2021.


Alderman:

Byron Sigcho-Lopez 25th Ward


7601
EVO COR

T-Mobile
CLINTON CORRIDOR
606 WEST ROOSEVELT ROAD
CHICAGO, IL 60607

EXTERIOR ELEVATIONS

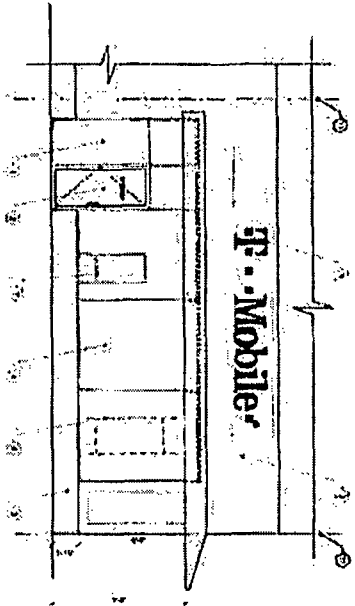


01 EXTERIOR ELEVATION

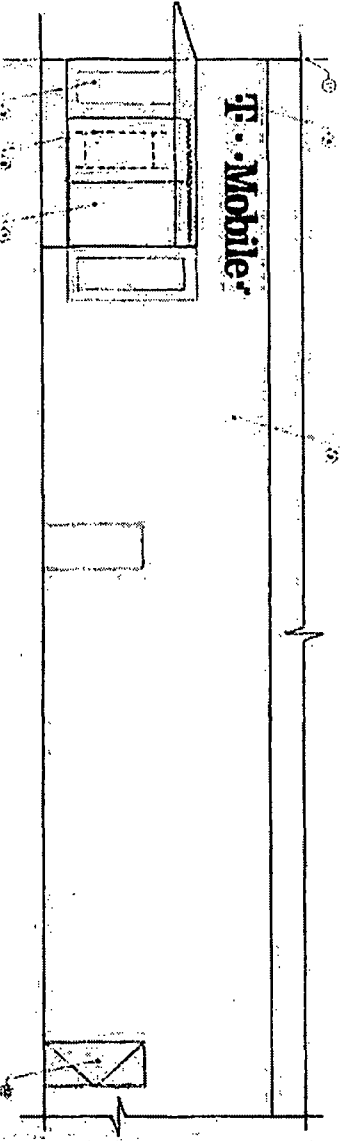

A1	EXTERIOR ELEVATION
----	--------------------



D9 : EXTERIOR PHOTO

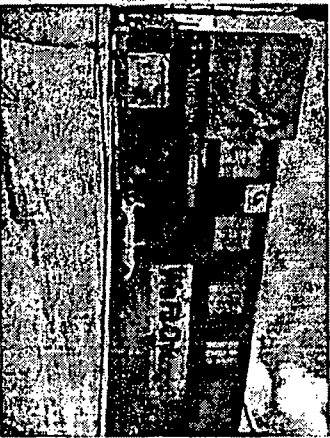

AS EXTERIOR PHOTO


H9 | SHEET NOTES

17/01/2018 15:30:01

BIG RED ROOSTER
a J.J. Company

300 S. MILL AVE, SUITE 201
TEMPE, AZ 85281
480.826.8904
www.bgliecorp.com

[illegible]

AS-BUILT DRAWING

 A-4

2



Department of Business Affairs and Consumer Protection
Small Business Center - Public Way Use Unit
City Hall - 121 N. LaSalle Street, Room 800, Chicago, IL 60602
312-74-GOBIZ / 312-744-6249 • (312) 744-1944 (TTY)
<http://www.cityofchicago.org/bacp>

07/21/2021

Alderman Byron Sigcho-Lopez
Ward # 25
City of Chicago
City Hall, Room 800
121 N. LaSalle Street
Chicago, IL 60602

Re: An ordinance to use and maintain a portion of the public right-of-way for **2 Sign(s)** for **T-MOBILE**, adjacent to the premises known as **606 W ROOSEVELT RD.**

Dear Alderman **Byron Sigcho-Lopez**:

The applicant referenced above has requested the use of the public right-of-way for **Sign(s)**. An ordinance has been prepared by the Department of Business Affairs and Consumer Protection - Small Business Center - Public Way Use Unit for presentation to the City Council. Because this request was made for properties located in your ward, as approved by you as per the attached, I respectfully request that you introduce the attached ordinance at the next City Council meeting.

If you have any questions regarding this ordinance, please contact Anthony Bertuca at (312) 744-5506.

Department of Business Affairs and Consumer Protection